

FED AID PROJ NO.	FED ROAD DIST NO.	STATE	COUNTY	DOCKET NO.	ROUTE NO.	SHEET NO.
	14	S.C.	Newberry	36.241	177	1-A

SOUTH CAROLINA STATE HIGHWAY DEPARTMENT

FINAL CONSTRUCTION PLANS

BRIDGE

INDEX

SHEET NO. 1-A DESCRIPTION

- 1 TITLE SHEET
- 2-12 PLANS
- 17-19 RECAPITULATION SHEETS
- 13-15 PROFILE
- 16 PILING DIAGRAM

OVER CANNONS CREEK & KINGS CREEK

DOCKET NO. 36.241 F.A. PROJ. NO. FI-2562 (5)

COUNTY NEWBERRY

ON RT. 177 BETWEEN POMARIA AND U.S. 176

PROGRESS DATA

CONTRACT AWARDED NOV 29 1948

WORK BEGAN FEB 1 1949

PROJECT ACCEPTED _____ 19_____

CONTRACTOR JOS. W. BARNWELL, JR.
TYPE OF BRIDGE REINF. CONCRETE

BRIDGE ENGINEER W. J. GOODING, JR.

BRIDGE FIELD ENGINEER _____

RESIDENT ENGINEER E. S. SUTHERLAND

NOTES TO RESIDENT ENGINEER:

Notes on recapitulation sheets should be read carefully and complied with in full. The Resident Engineer should personally check the plans against the following list:—

1. Ink drawings and computations of all excavation, showing division of Dry, Wet and Rock excavation.
2. Ink drawings on translucent paper of pile bents or foundation piles and pile record, so arranged that the location of each pile, its length, penetration and bearing capacity is shown.
3. Ink drawings on translucent paper of all changes from plans, with computations of changes in Quantities.
4. Summary of Quantities.
5. Cement record to substantiate adjustments.
6. P.R. 47 - 2 copies (Federal Aid Project only).
7. Force Account Claims and bills (if necessary).
8. Adjustment of cement cost due to variation in yield (5 copies).
9. Cement Invoices accompanying adjustments.
10. Freight Bills and Register.
11. Overrun and Underrun sheets (2 copies).
12. Property Releases (if necessary).
13. Estimate (5 copies).
14. Statement of the amount to be deducted due to overtime.
15. Letter of Transmittal.
16. Final Roadway Profile.
17. Tie between S.C.H.D. Datum and Mean Sea Level.

	RES. ENGR. CHECK	COL'A. OFFICE CHECK
1		
2	✓	✓
3		
4	✓	✓
5	✓	✓
6		
7		
8		
9		
10	✓	
11		
12		
13		
14		
15		
16		✓
17		

Overruns and Underruns are to be explained in such a manner as to leave no doubts as to the reasons.

Following data to be inked on front of each note book:—
 Docket Number (as shown by original plans), Book Number, Contents, Contractor, Resident Engineer, Date Completed, Type of Bridge.

THE FINAL NOTE BOOKS, PROPERLY MARKED AND DESCRIBED, SUBMITTED HEREWITH AS A PART OF THESE FINAL CONSTRUCTION PLANS ARE AS FOLLOWS:—

BOOK NO. BOOK NO 1 CANNONS CREEK BR.

BOOK NO. " 2 KINGS " "

BOOK NO.

BOOK NO.

BOOK NO.

DIARY

DATA CORRECT E. S. Sutherland 2-2-50
 RESIDENT ENGINEER DATE

PLANS AND QUANTITIES CHKD. W. B. Bellinger 3-17-50
 BRIDGE ESTIMATE ENGINEER DATE

EXAMINED _____
 ASSISTANT BRIDGE ENGINEER DATE

SOURCE OF SUPPLY OF MATERIAL

ITEM	MANUFACTURER	GRADE
SAND	DIXIANA COLUMBIA S.C.	# 10
CRUSHED STONE	BLAIR BLAIR S.C.	# 4
GRAVEL		
CEMENT	VOLUNTEER KNOXVILLE TENN.	TYPE II
REINF. STEEL	ALABAMA STEEL CO BIRMINGHAM ALA.	
STRUCT. STEEL		
TREATED TIMBER		
STEEL H PILING		
TR. STRUCT. TIMBER		
HARDWARE		
EXPANSION PLATES		
PAINT	Sou. Coating & Chemical Co Sumter S.C.	
WATERPROOFING		
HANDRAIL (STEEL)	UNION IRON WORKS UNION S.C.	

TABLE OF OVERRUNS AND UNDERRUNS

ITEM	UNIT	PLAN QUANTITIES	RES. ENGINEER QUANTITIES	PAY QUANTITIES COL'A. OFFICE	OVERRUN	UNDERRUN	EXPLANATION
EXCAVATION							
DRY EXCAVATION	C.Y.						
WET	C.Y.						
ROCK	C.Y.						
WET AND DRY EXCAV.	C.Y.						
CEMENT							
CLASS "AA" CONCRETE	C.Y.						
CLASS "A" CONCRETE	C.Y.	482.32	482.32				
REINFORCING STEEL							
REINFORCING STEEL	LBS.	114,306	114,306				
STRUCTURAL TIMBER							
TREATED STRUCT. TIMBER	M.B.M.						
UNTREATED STRUCT. TIMBER	M.B.M.						
HARDWARE							
HARDWARE	LBS.						
STRUCTURAL STEEL							
STRUCTURAL STEEL	LBS.						
STEEL SUPERSTRUCTURE	L.SUM						
PILING							
UNTREATED TIMBER PILING	L.F.						
CREOSOTED "	L.F.						
CUT-OFF C.T. PILING @ 40 %	L.F.						
CUT-OFF C.T. PILING @ 25 %	L.F.						
16 IN. PRE-CAST R.C. PILING	L.F.	1620	1674.42		54.42		Necessary to obtain bearing
IN PRE-CAST R.C. PILING	L.F.						
STEEL H PILING (IN LBS)	L.F.						
PAINING							
FIELD PAINTING STRUCTURAL STEEL	L.SUM						
HANDRAIL							
METAL HANDRAIL	L.F.						
PIPE	L.F.	600	600				
TIMBER	L.F.						
OTHER ITEMS							
PRE-CAST CONC. TILE SLOPE DRAINS	L.F.	165	177.5		12.5		Necessary to fit full shapes

INDEX OF SHEETS

SHEET NO. 1	TITLE SHEET
" 2	FLARED CURB & GUTTER
" 3	CONCRETE TILE SLOPE DRAINS
" 4	PIPE HANDRAIL
" 5	ROAD PLAN & PROFILE - CANNONS CREEK
" 6	BRIDGE PLAN & PROFILE - " "
" 7	BENT DETAILS - " "
" 8	30' SUPERSTRUCTURE DETAILS - " "
" 9	ROAD PLAN & PROFILE - KINGS CREEK
" 10	BRIDGE PLAN & PROFILE - " "
" 11	BENT DETAILS - " "
" 12	30' SUPERSTRUCTURE DETAILS - " "


SOUTH CAROLINA
STATE HIGHWAY DEPARTMENT
COLUMBIA

PLAN AND PROFILE OF PROPOSED
STATE HIGHWAY

FEDERAL AID PROJECT NO. FI-2562 (5)
S.C. DOCKET NO. 36.241
ROUTE NO. 177
NEWBERRY COUNTY
BRIDGES OVER
CANNONS CREEK & KINGS CREEK

FED. ROAD DIV. NO.	STATE	COUNTY	FED. AID PROJ. NO.	ROUTE NO.	SHEET NO.	TOTAL SHEETS
3	S.C.	NEWBERRY	FI-2562(5)	177	1	19

Item	Cannons Creek	Kings Creek	Total
Class "A" Concrete	C.Y. 287.05	C.Y. 195.27	C.Y. 482.32
Reinforcing Steel	Lbs. 63,424	Lbs. 45,882	Lbs. 114,306
16" Pre-cast Concrete Piling	L.F. 995	L.F. 625	L.F. 1,620
Pre-cast Concrete Tile Slope Drains	L.F. 120	L.F. 45	L.F. 165
Pipe Handrail	L.F. 360	L.F. 240	L.F. 600

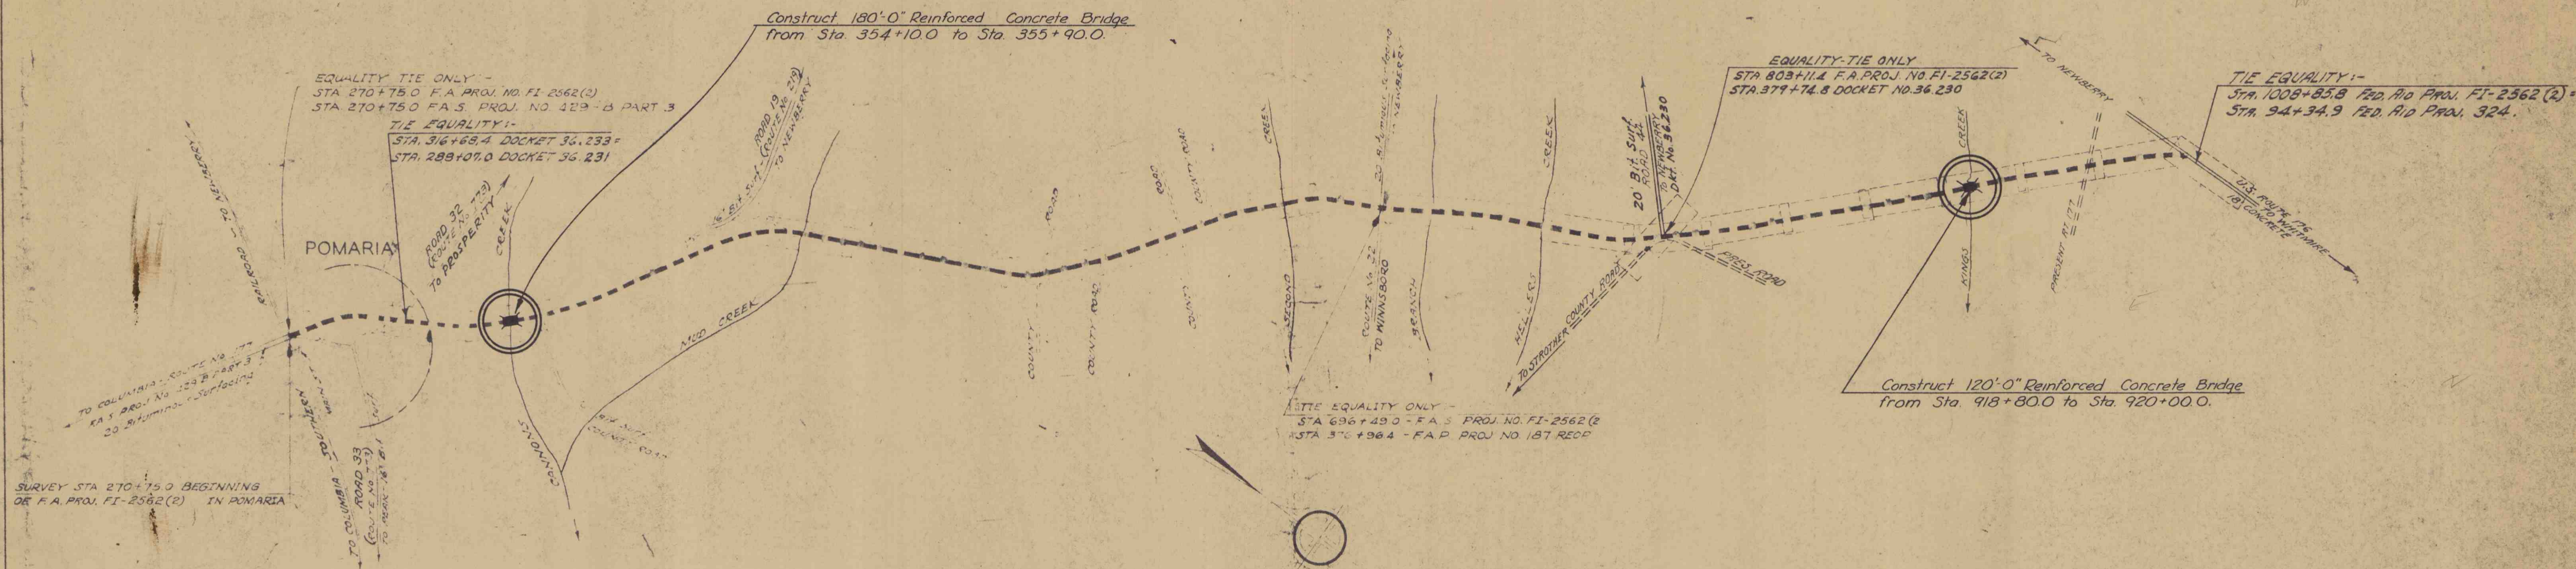


SURVEY STA 270+75.0 BEGINNING OF F.A. PROJ. FI-2562(2) IN POMARIA

State Line	-----	Trolley Poles	•••••
County Line	-----	Power Poles	•••••
City/Town Limits	-----	Telephone Trolley poles	•••••
Proprietary Line	-----	Moss	•••••
Fence	-----	Trees	•••••
Retaining Wall	-----	Buildings	•••••
Existing Road	-----	Bridge	•••••
Proposed Road	-----	Concrete Box Culvert	•••••
Railroad	-----	Pipe Culvert	•••••
Levee or Embankment	-----	Drop Inlet and Outlet	•••••
Guard Rail	-----	Hub on Center Line	•••••
Point of Intersection (P.I.)	•		



Net Length of Roadway	0.000 Miles
Net Length of Bridges	0.056 Miles
Net Length of Project	0.056 Miles
Length of Exceptions	0.000 Miles
Gross Length of Project	0.056 Miles

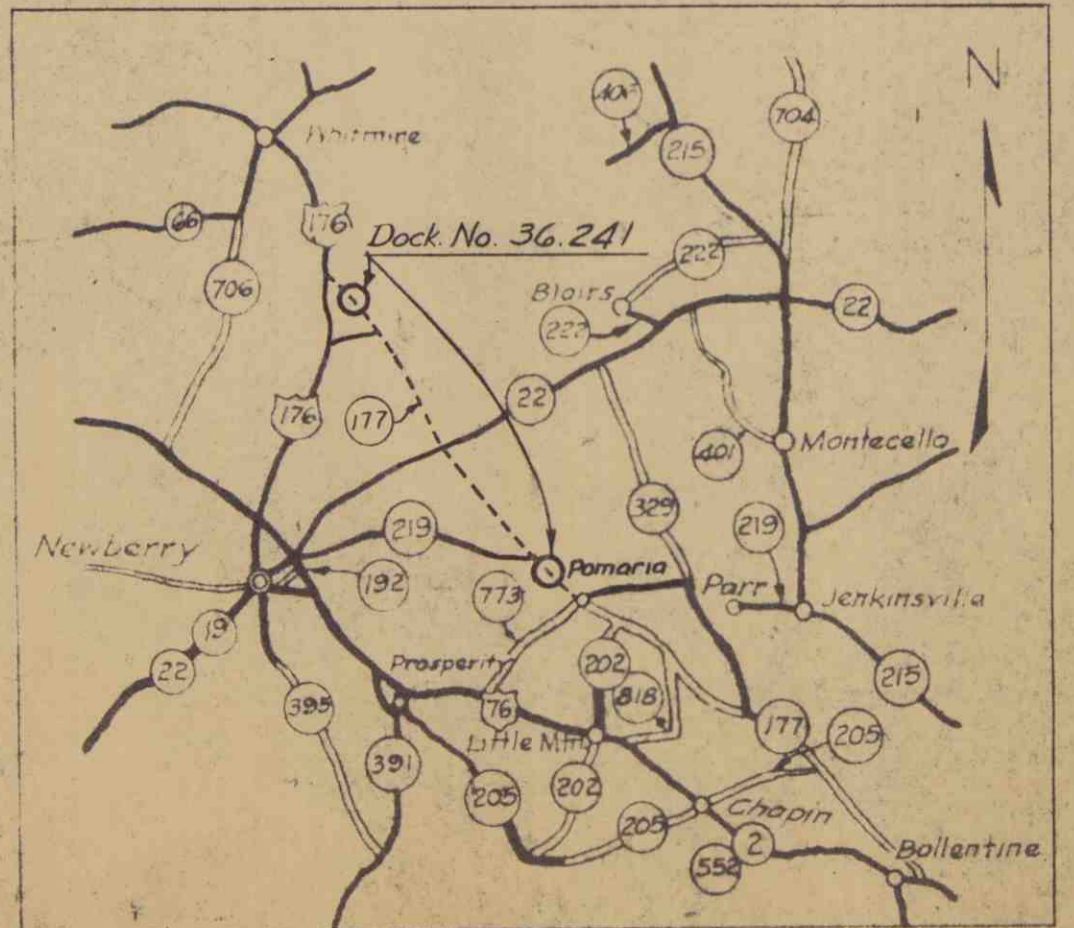

Note: All workmanship and material on this project to conform with South Carolina State Highway Department Standard Specifications for Highway Construction dated March 15th, 1939, as approved by the Administrator, Federal Works Agency.

APPROVED

S. N. Pearson
STATE HIGHWAY ENGINEER
DATE 10/19/48


RECOMMENDED FOR APPROVAL

DISTRICT ENGINEER
PUBLIC ROADS ADMINISTRATION
FEDERAL WORKS AGENCY


APPROVED

DIVISION ENGINEER
PUBLIC ROADS ADMINISTRATION
FEDERAL WORKS AGENCY

SKETCH
SHOWING
FLARE AT BRIDGE ENDS
Scale
1 inch = 5 feet

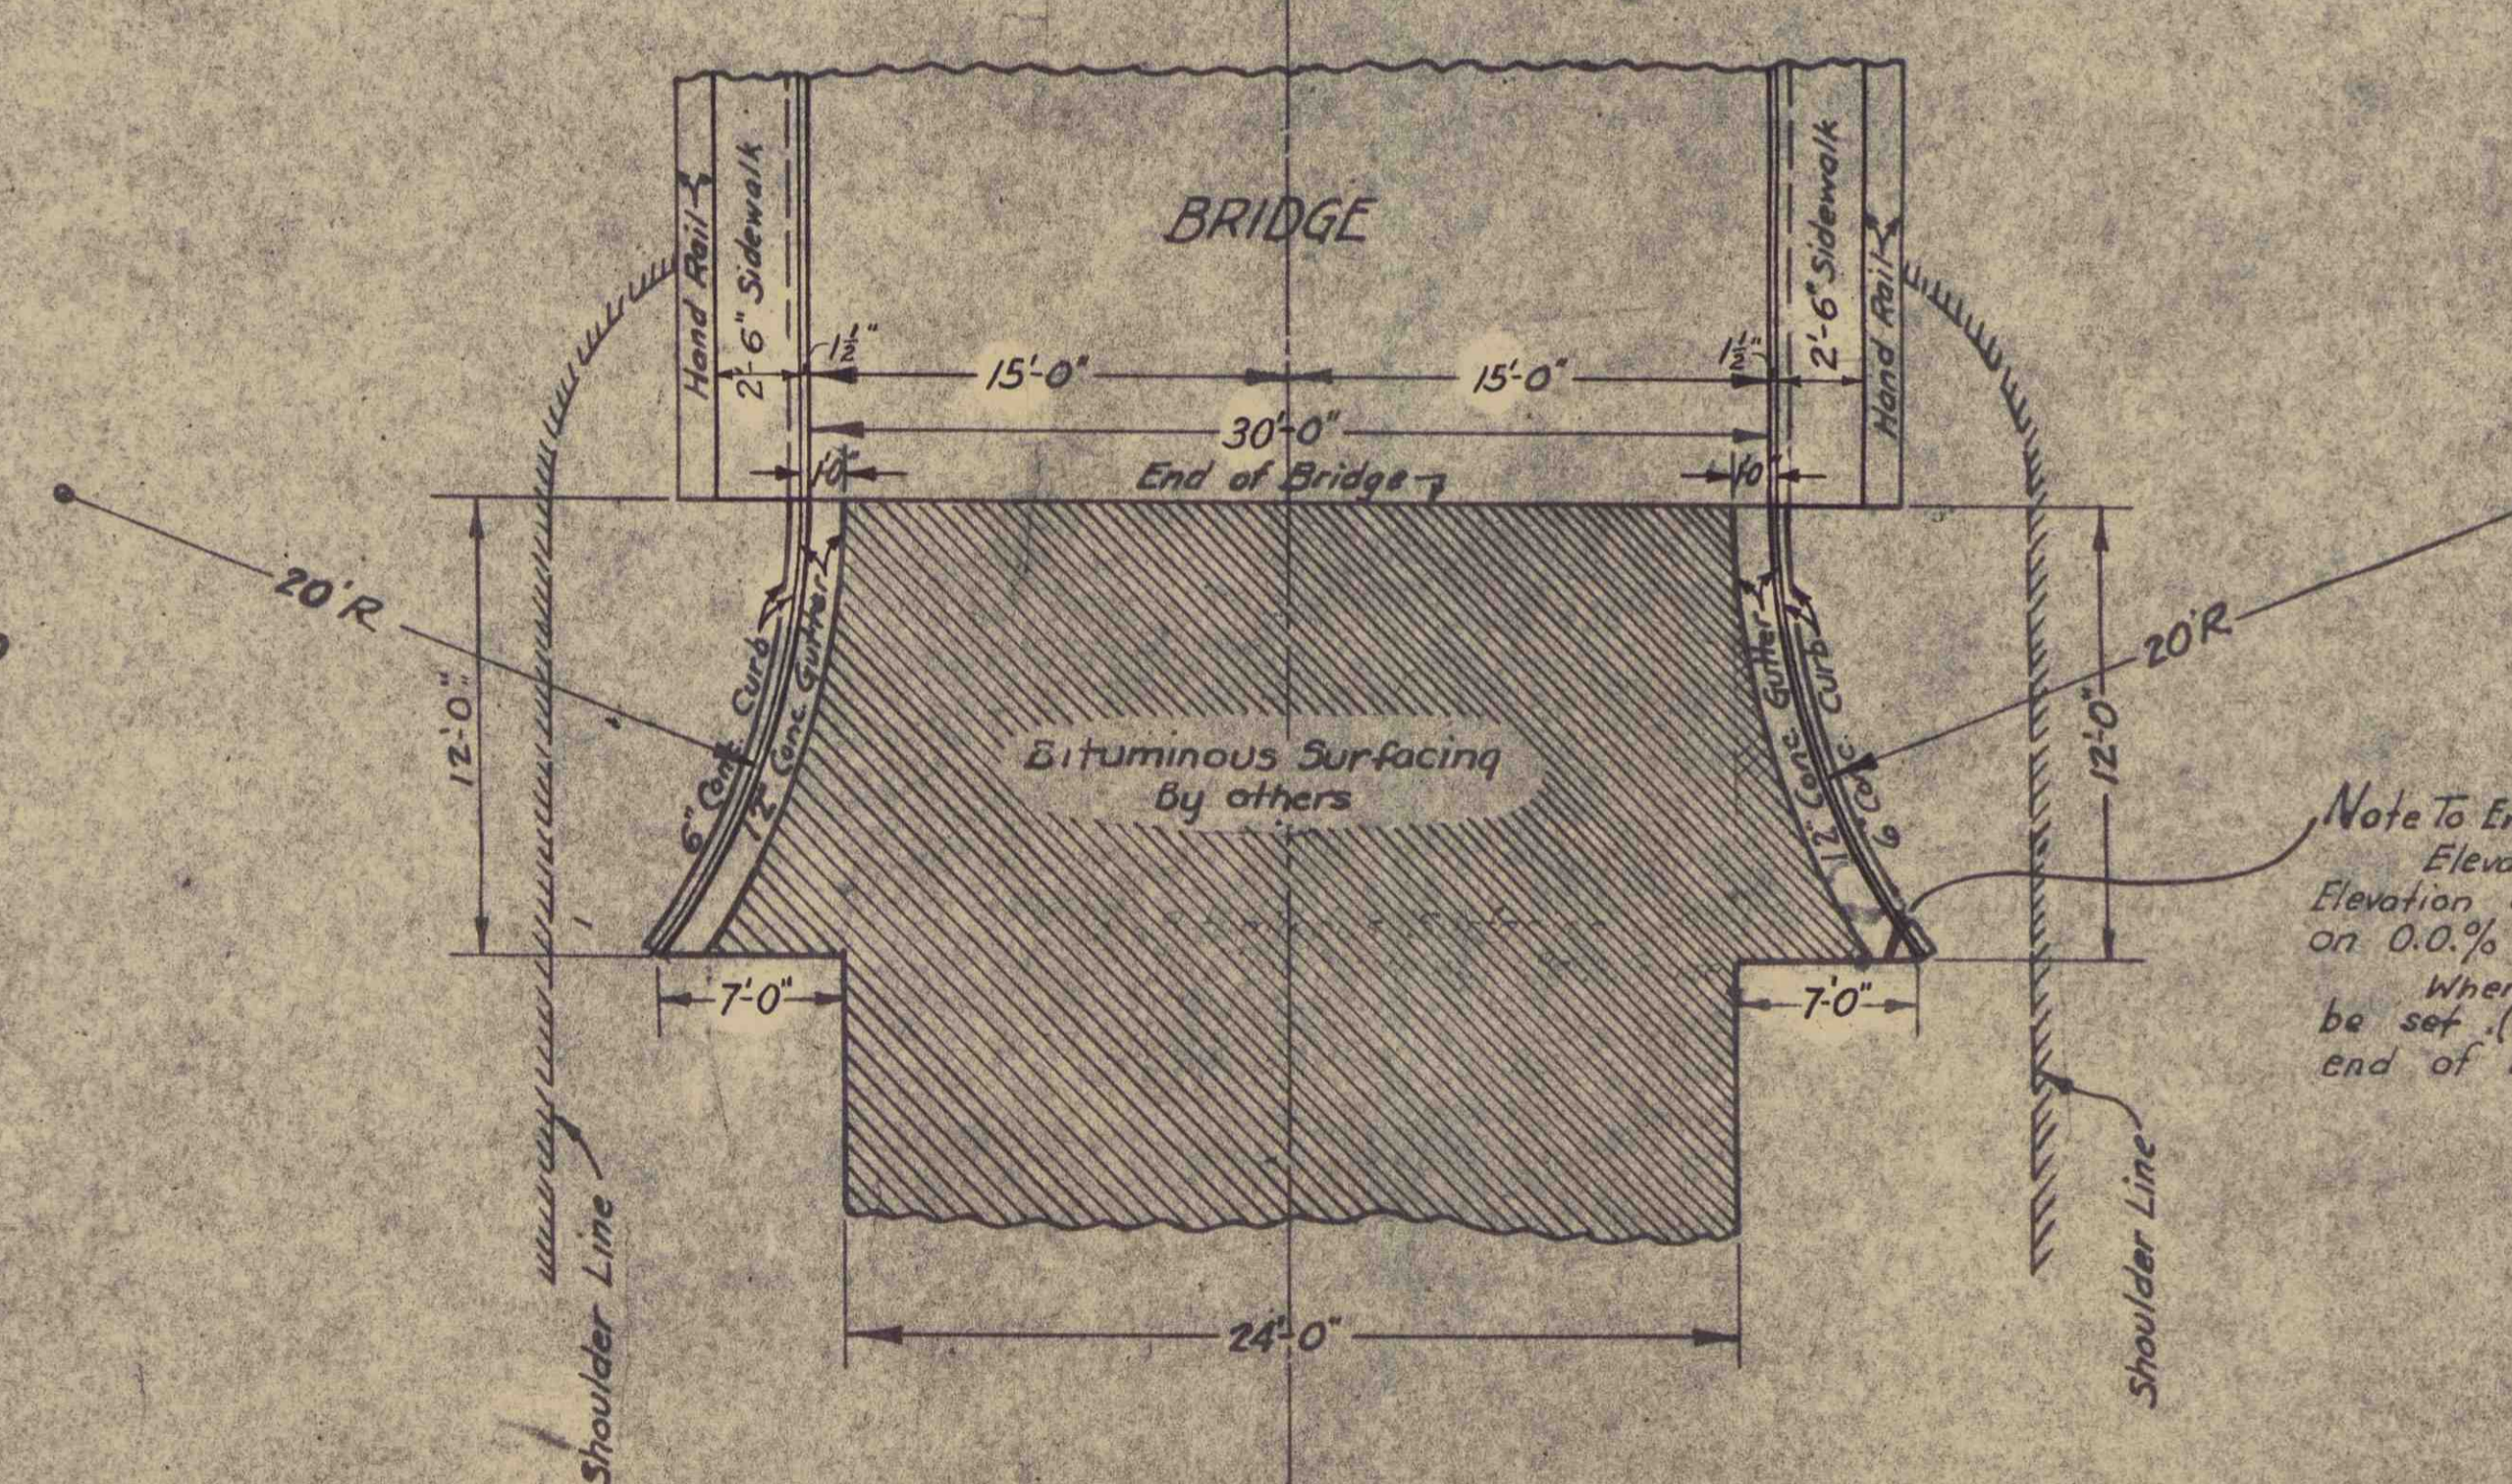

DETAIL
OF
CONC. CURB AND GUTTER
Scale
1 inch = 6 inches

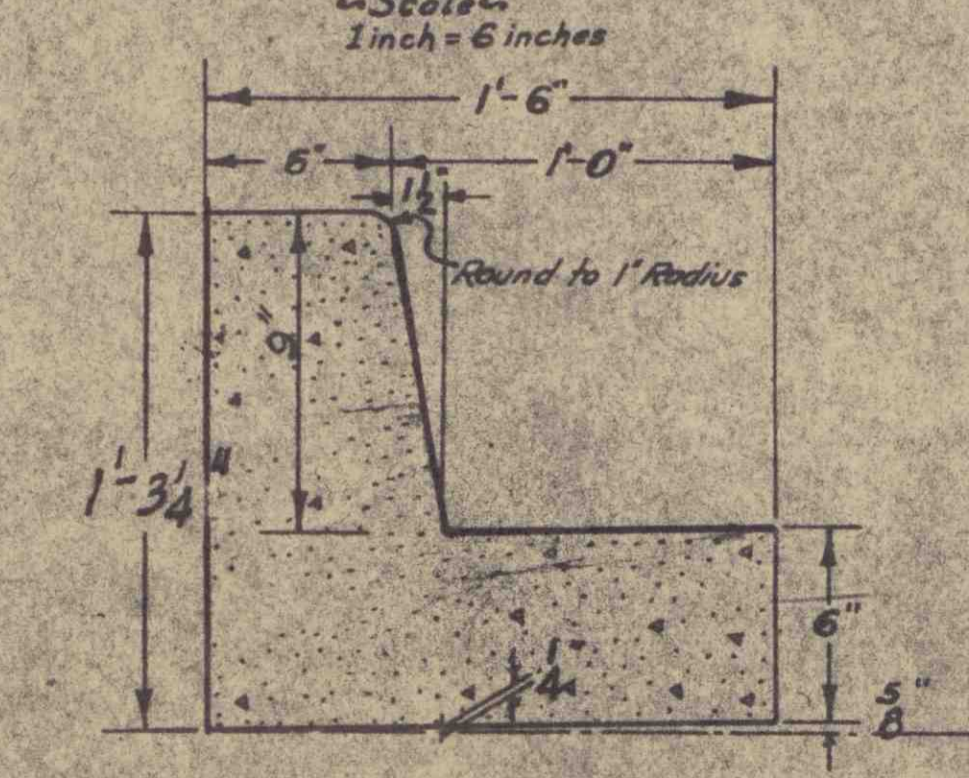

CURB & GUTTER QUANTITIES - ONE END - ONE BRIDGE
Class "A" Concrete for one end of bridge = 112 C.Y.


Note To Engineers:
Elevation of this point to be set 6" below
Elevation of gutter at end of Bridge where approach is
on 0.0% grade.
When the approach is on a grade this point should
be set (6" ±% of grade x 12') below elevation of gutter at
end of bridge.

All costs of constructing the concrete curb and
gutter at the ends of the bridge will be included
in payment for the concrete involved at this Unit
Price Bid for Class "A" Concrete.

For Dock 36.241 A.M.H. 10-48 V.B.M.C. 10-48


S.C. STATE HIGHWAY DEPARTMENT
COLUMBIA
DETAIL OF
CURB AND GUTTER FOR SLOPE
DRAINS AT ENDS OF BRIDGE
S.C. DOCKET NO. 36.241 NEWBERRY COUNTY
ROUTE NO. 177 DATE OCT. 1948

FED. ROAD DIV. NO.	STATE	COUNTY	DOCKET NO.	ROUTE NO.	SHEET NO.	TOTAL SHEETS
3	S.C.	NEWBERRY	36 241	177	3	17

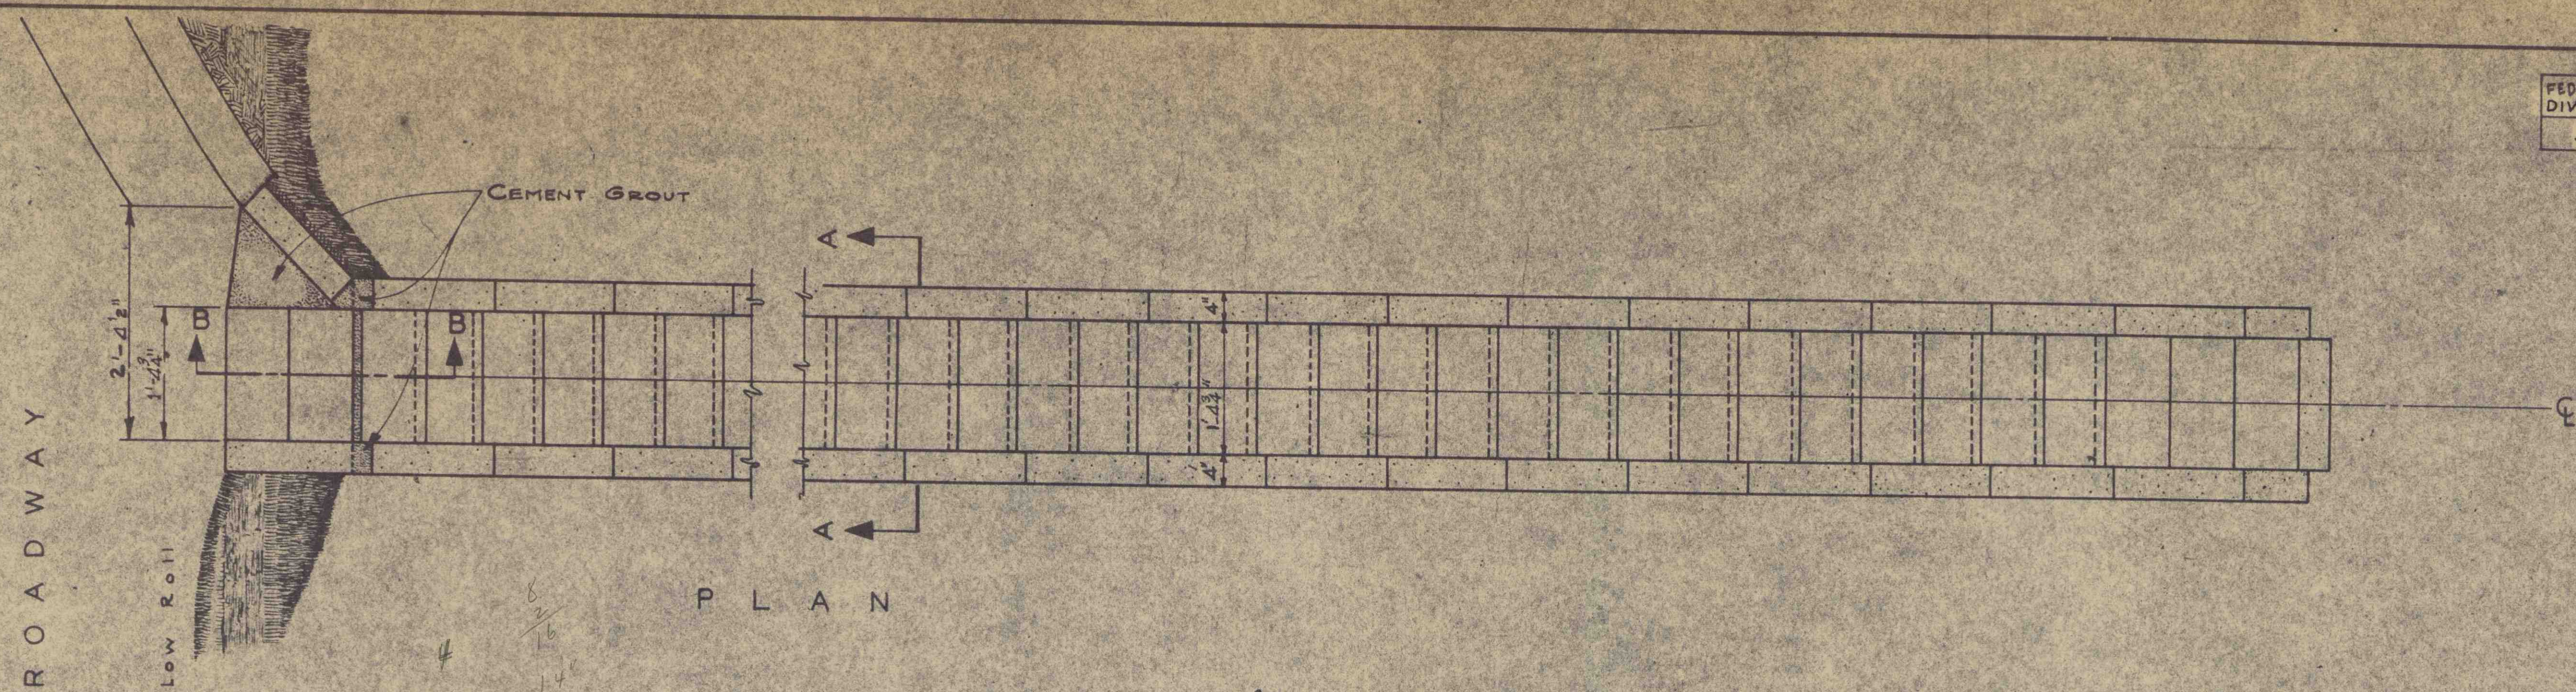


P L A N


* Resident Engineer to vary this dimension to suit shoulder

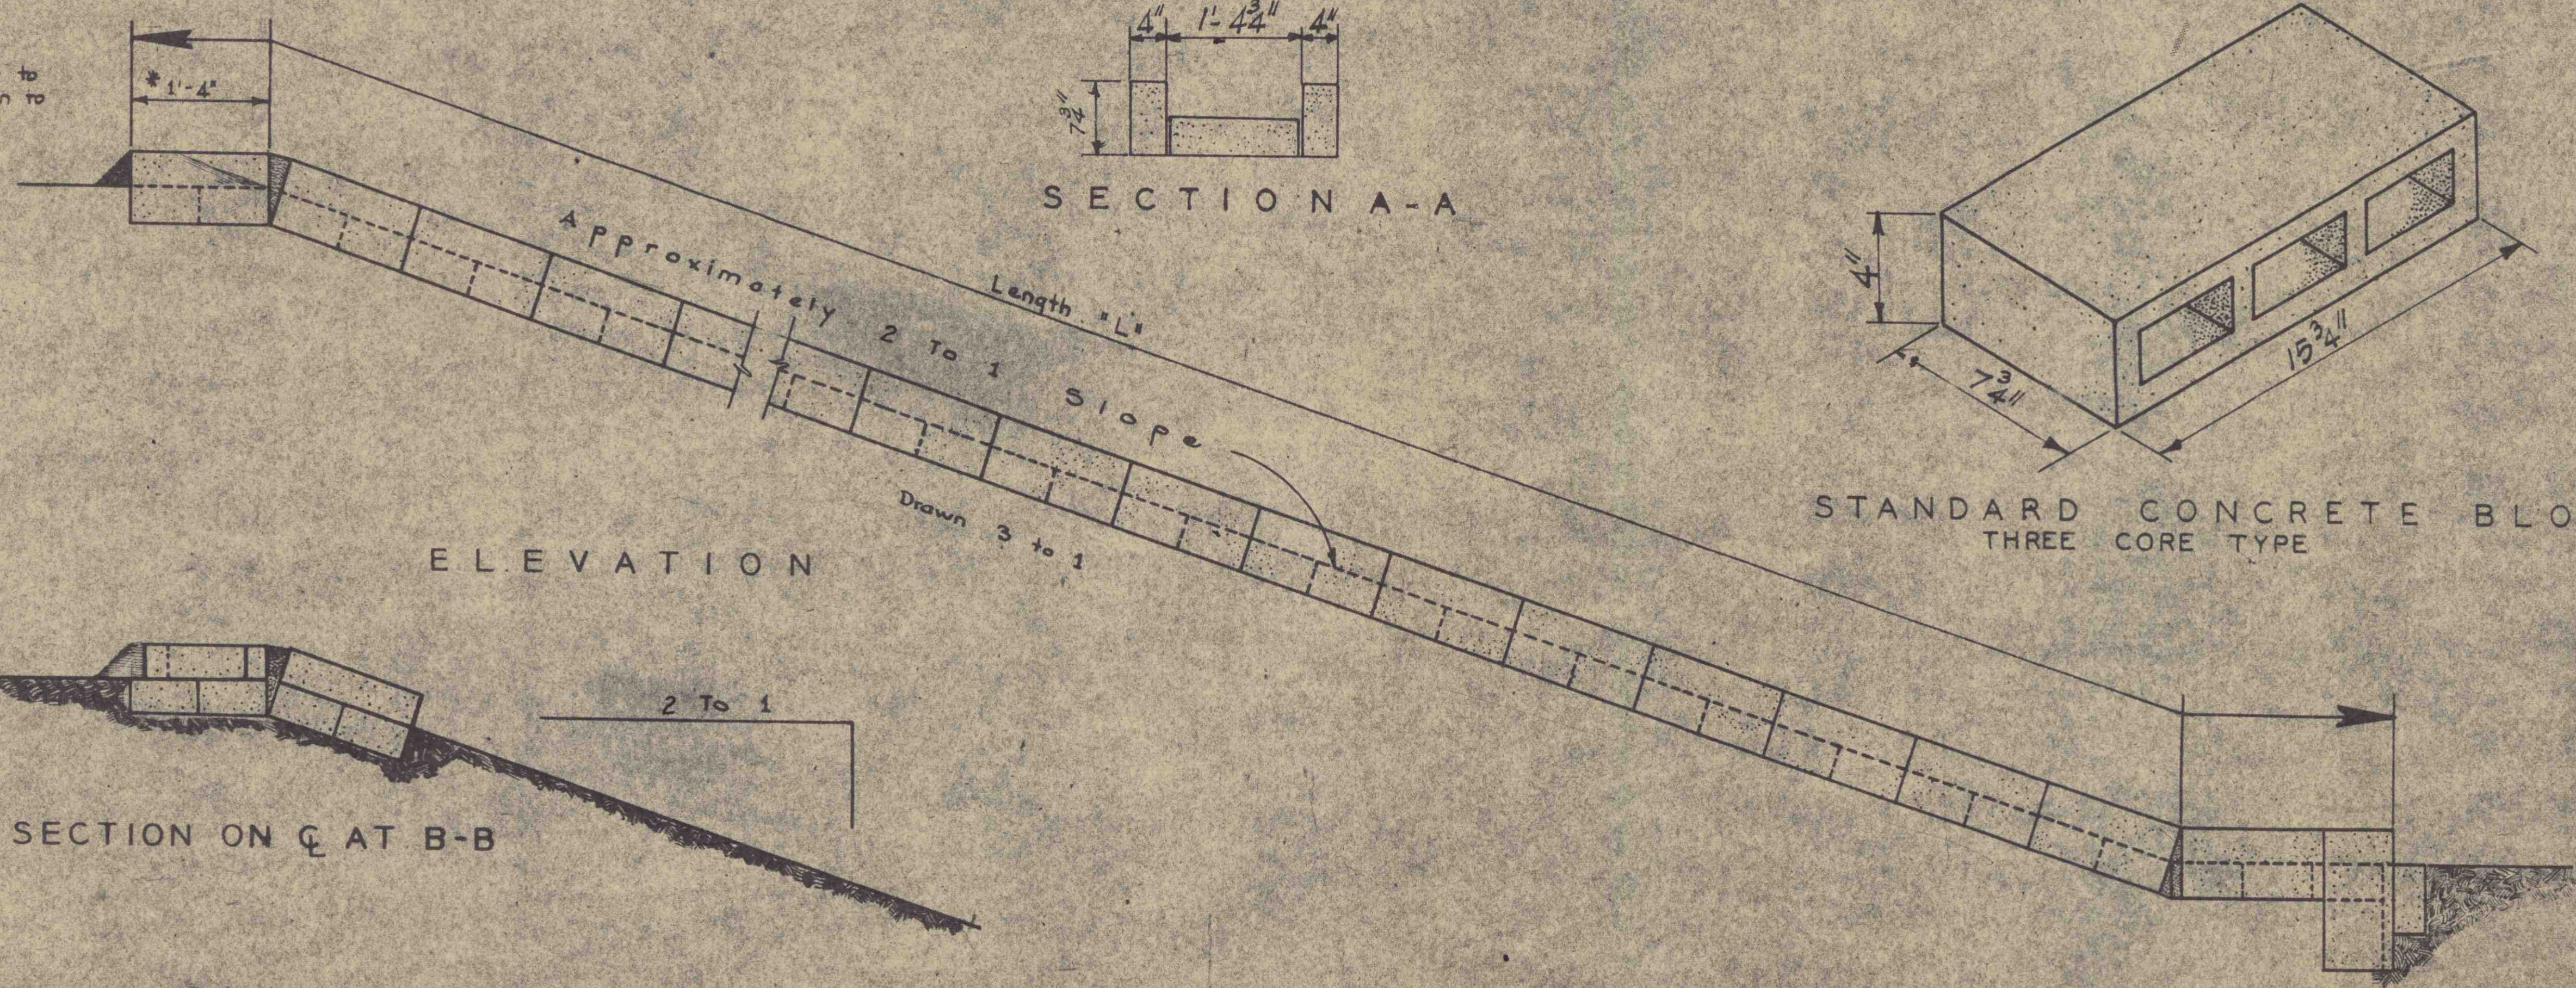


E L E V A T I O N

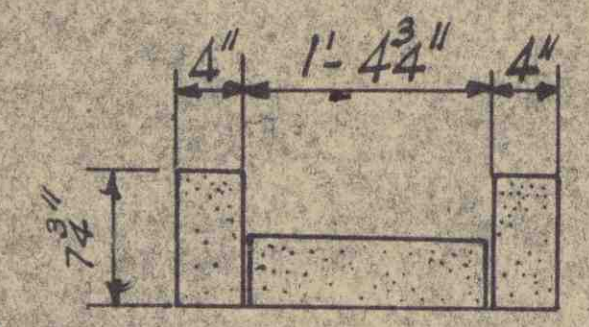

S E C T I O N A - A

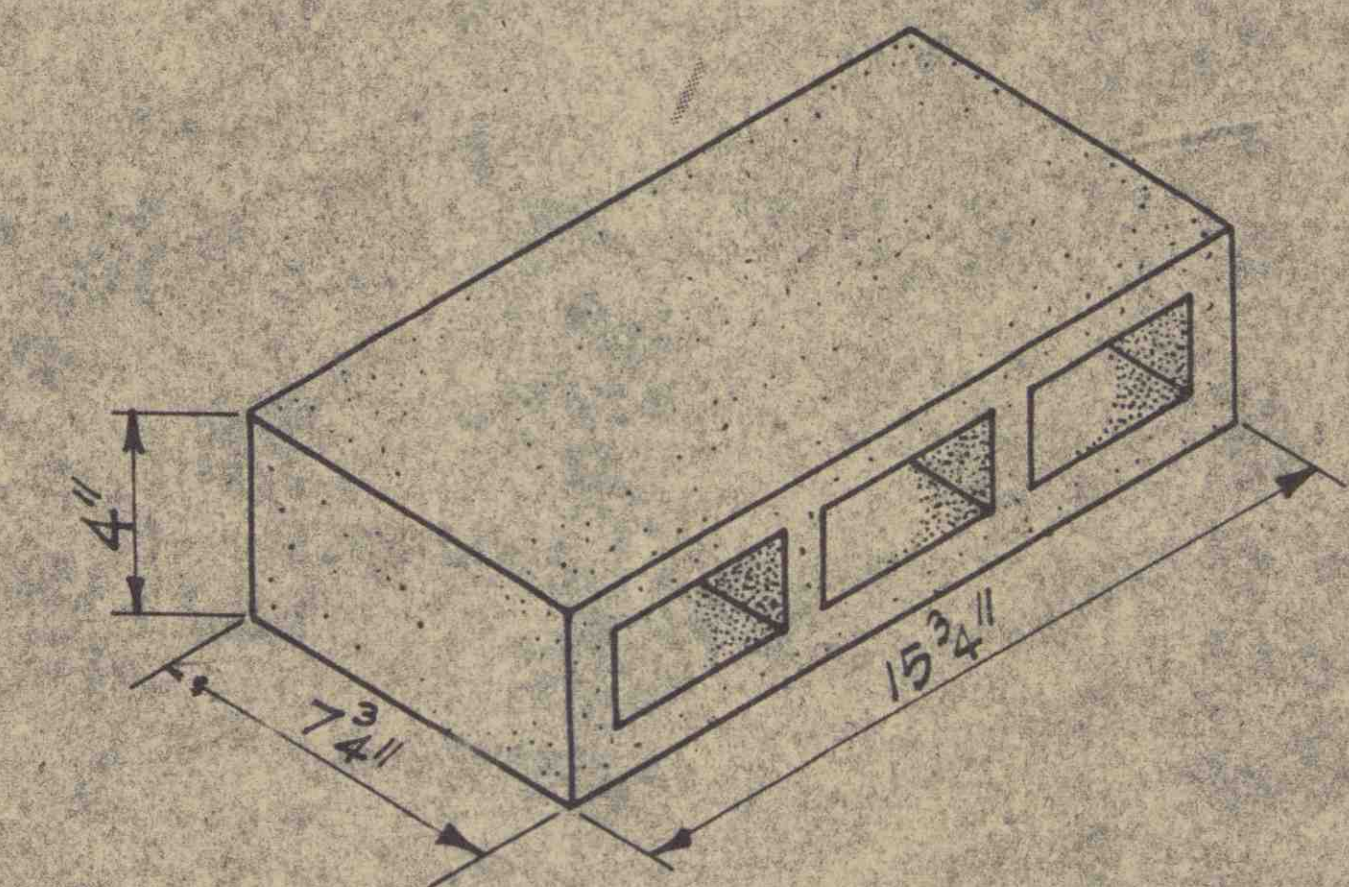

S T A N D A R D C O N C R E T E B L O C K
T H R E E C O R E T Y P E

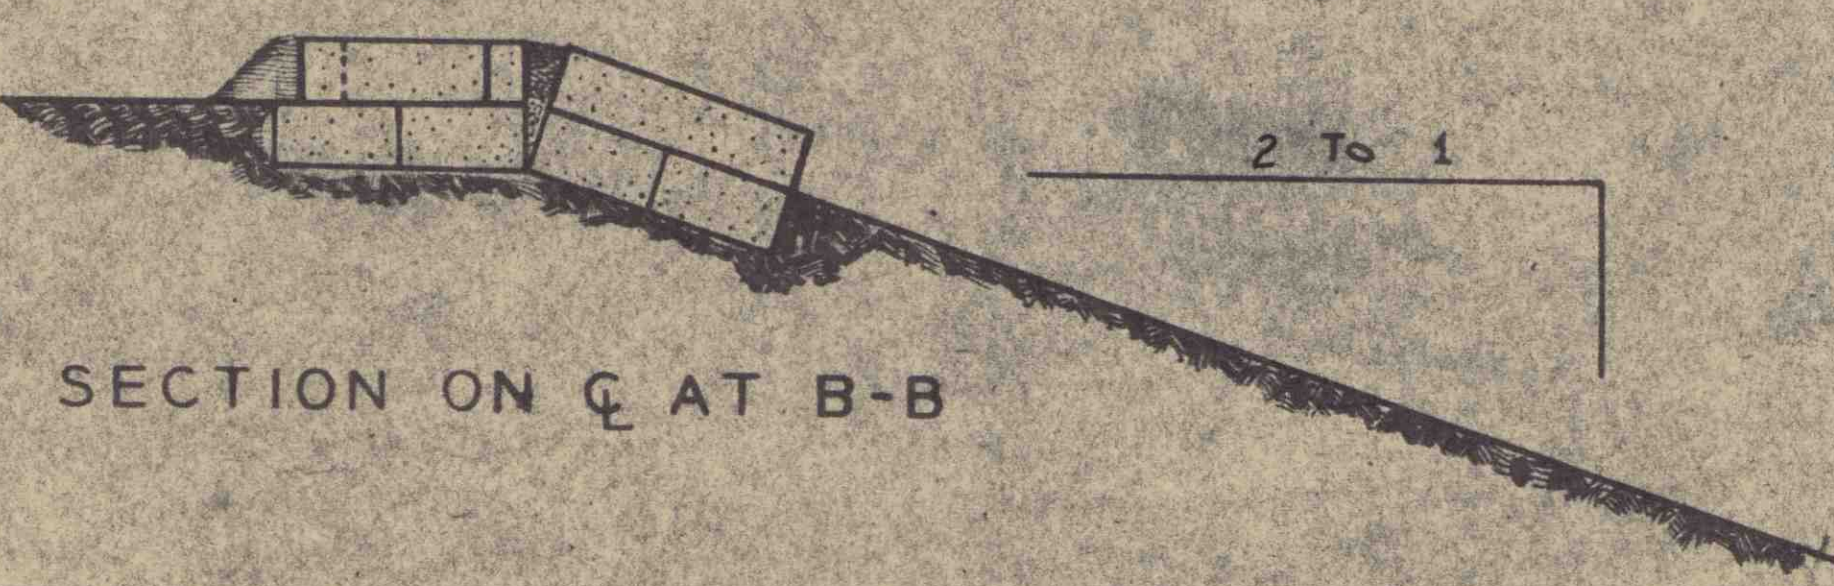

S E C T I O N O N C - C A T B - B

CANNONS CREEK 120
KINGS CREEK 45
TOTAL LENGTH 165 FT.

Scale 1" = 1 Ft












NOTE: Necessary concrete and extra blocks at end of drain will be paid for as 2 feet of slope drain at unit price bid per lin. ft. All blocks shall be laid with a 1/2" joint of 1:3 Mortar. All costs of necessary excavation for the construction of the slope drains shall be included in the unit price bid per lin. ft. of concrete Tile Slope Drains.

S. C. STATE HIGHWAY DEPARTMENT
COLUMBIA

TYPICAL CONCRETE TILE
SLOPE DRAINS


S. C. DOCKET NO. 36 241 NEWBERRY COUNTY
ROUTE NO. 177 DATE OCT. 1948

REV.	BY	DATE
1	V.V.T.	5-47
2	R.W.H.B.M.C.	10-48
3	H.R.T.	
4	H.R.T.	

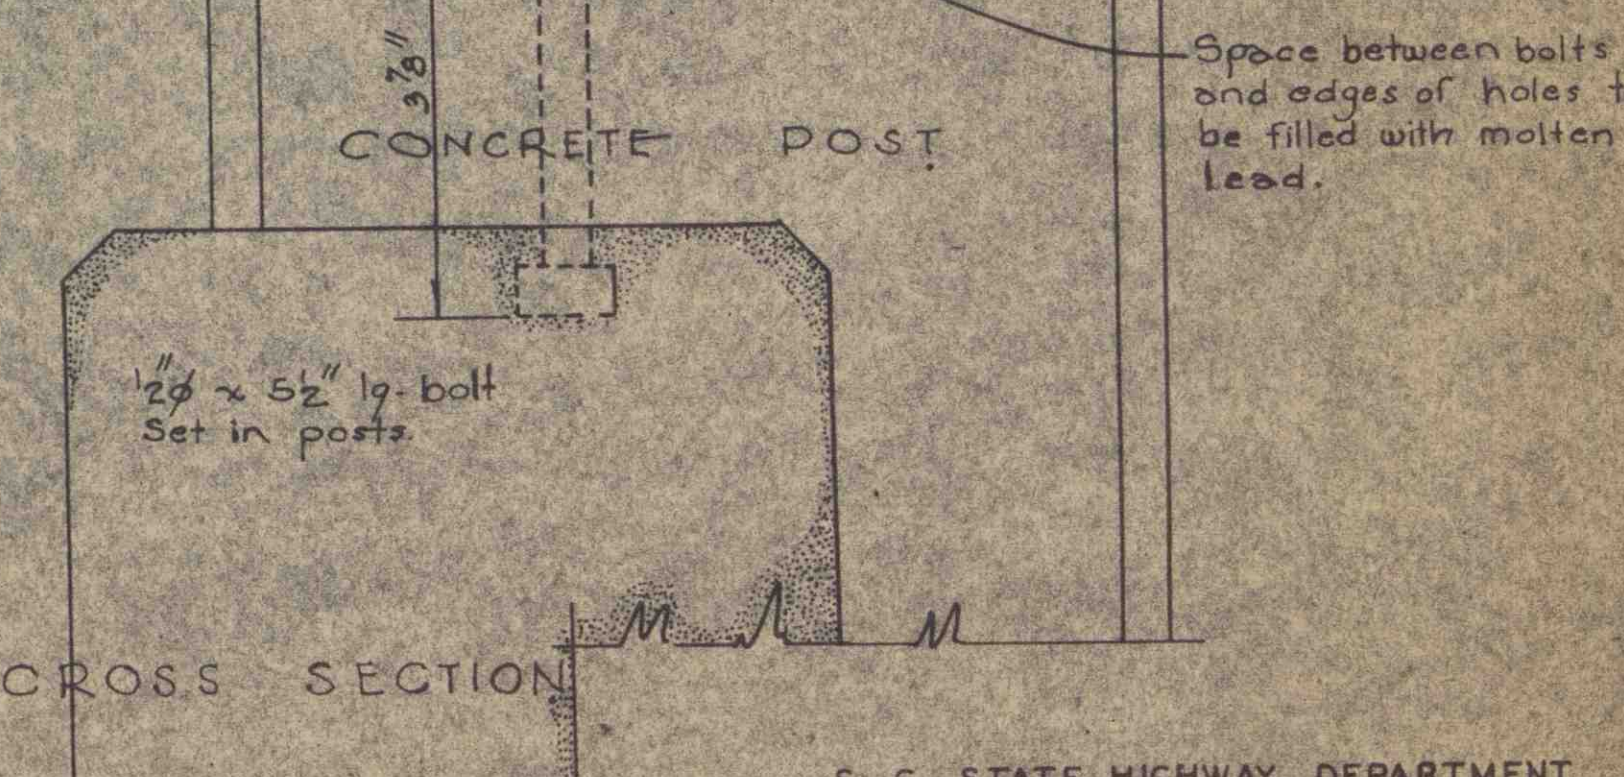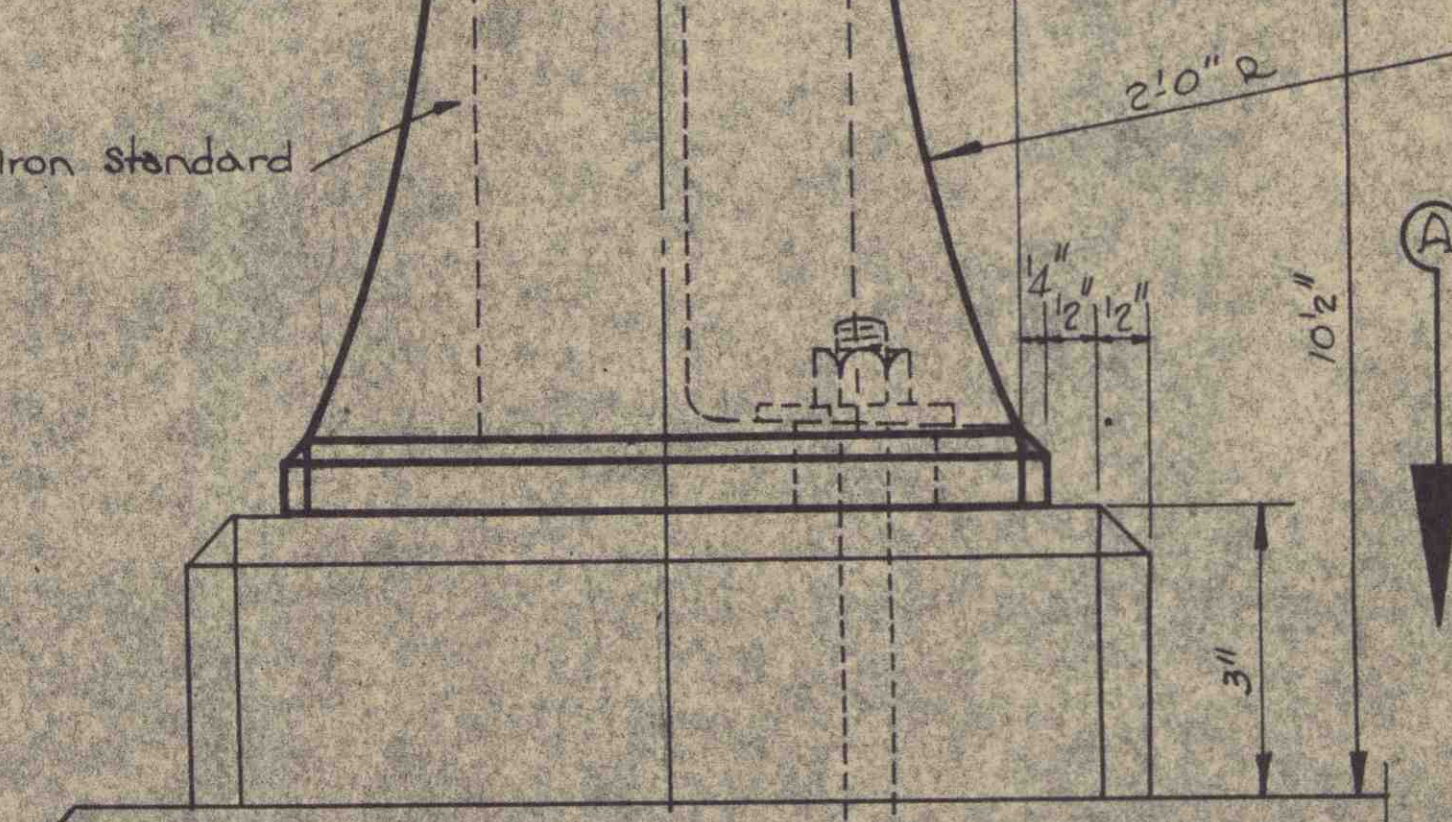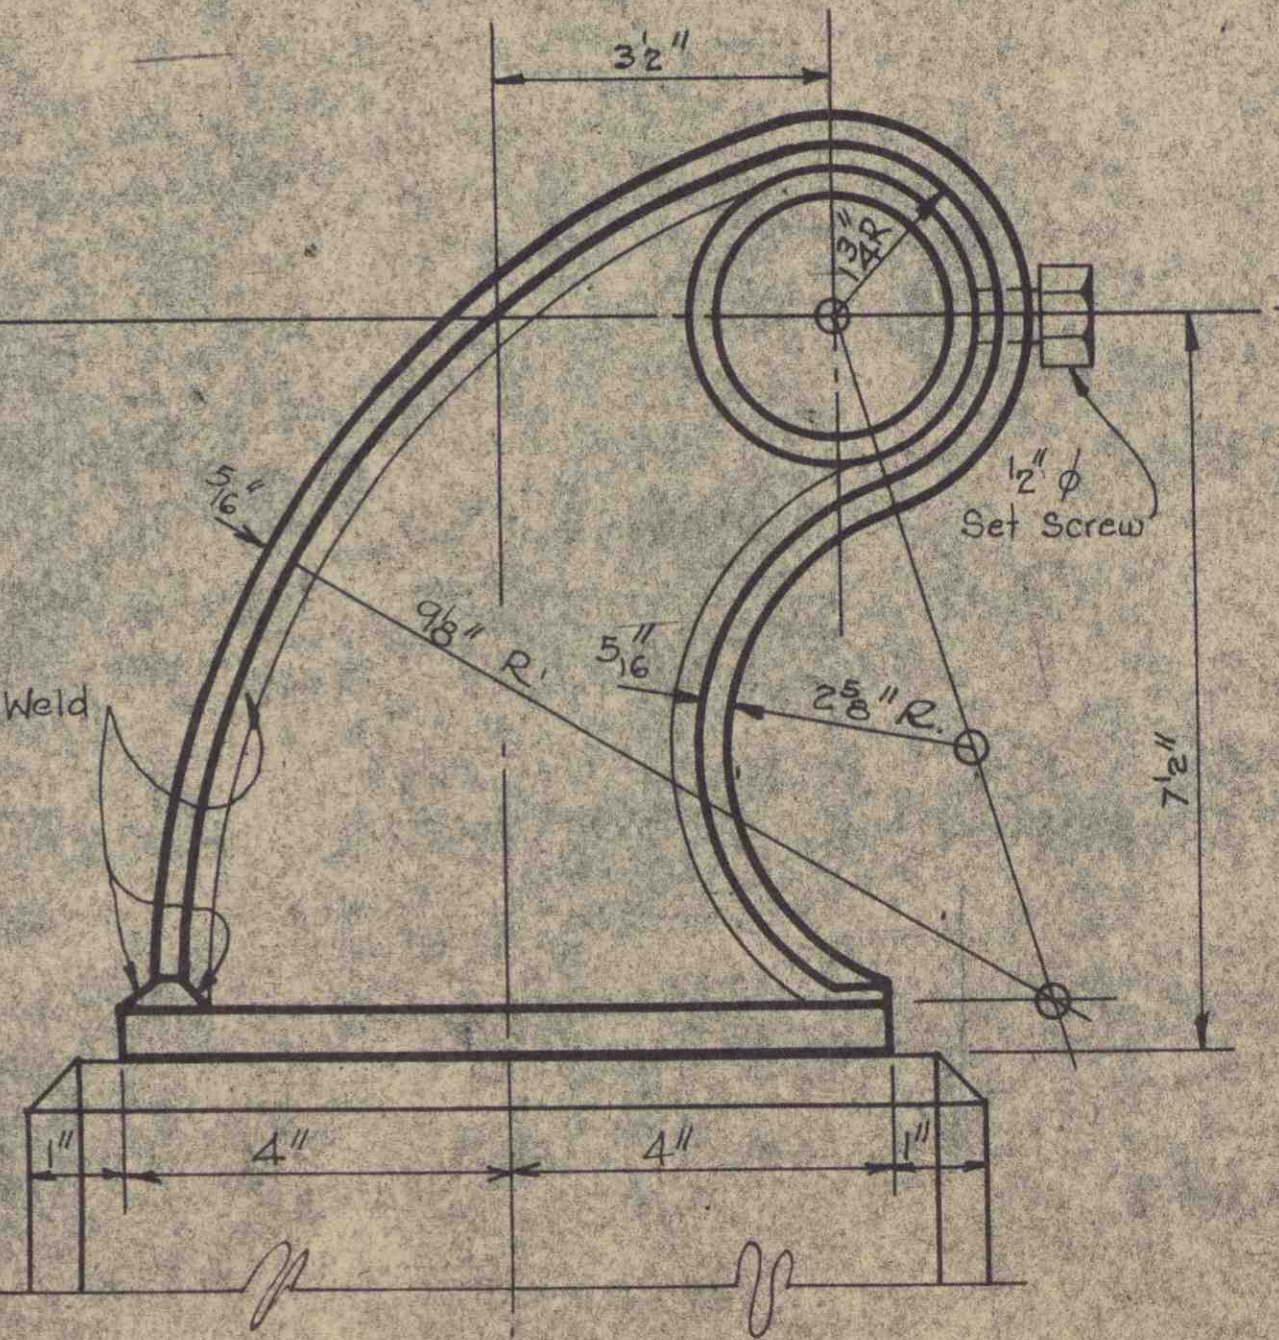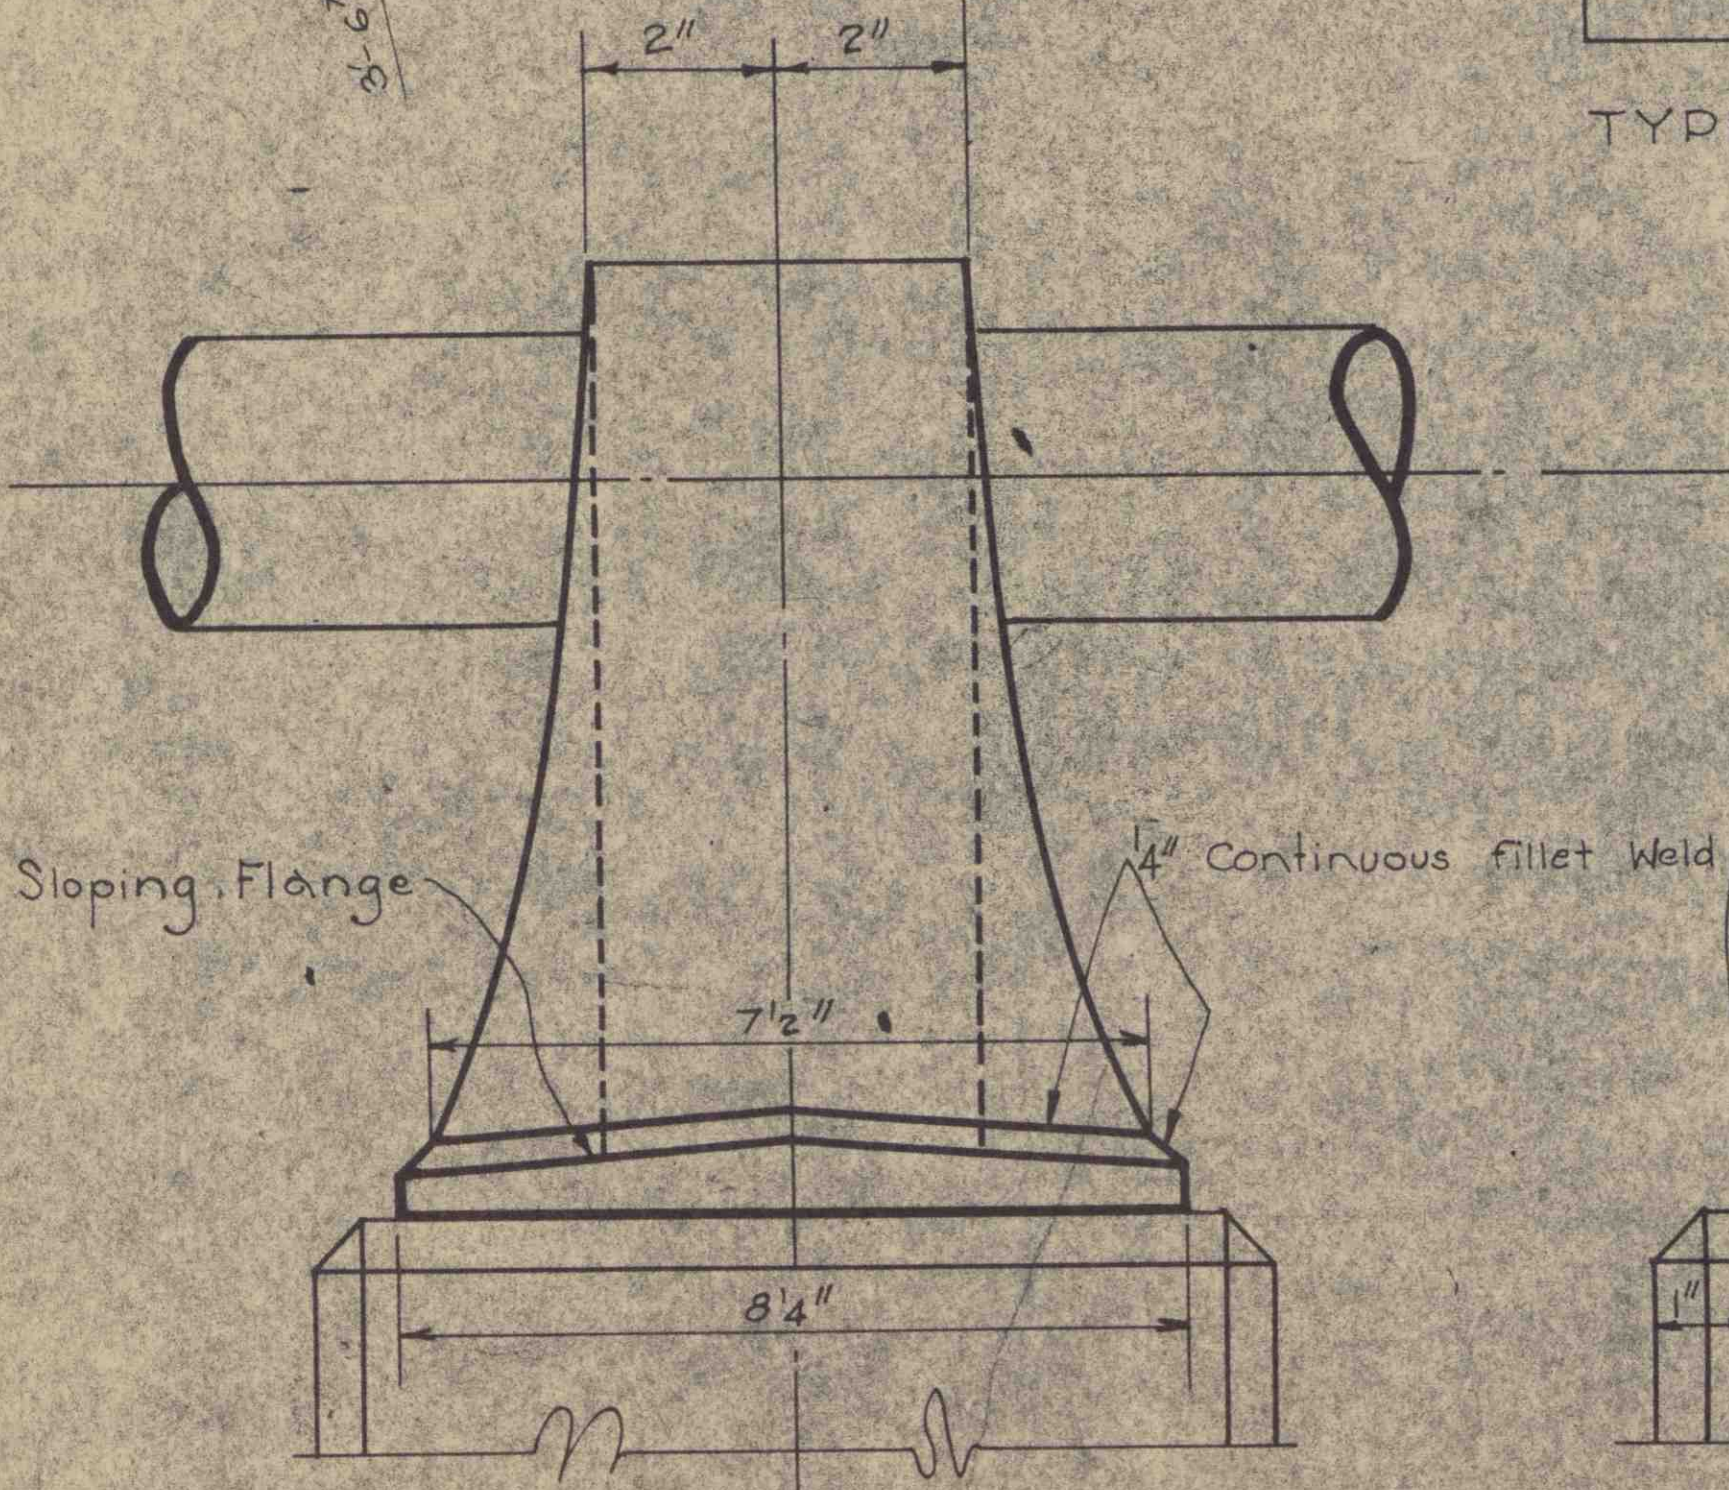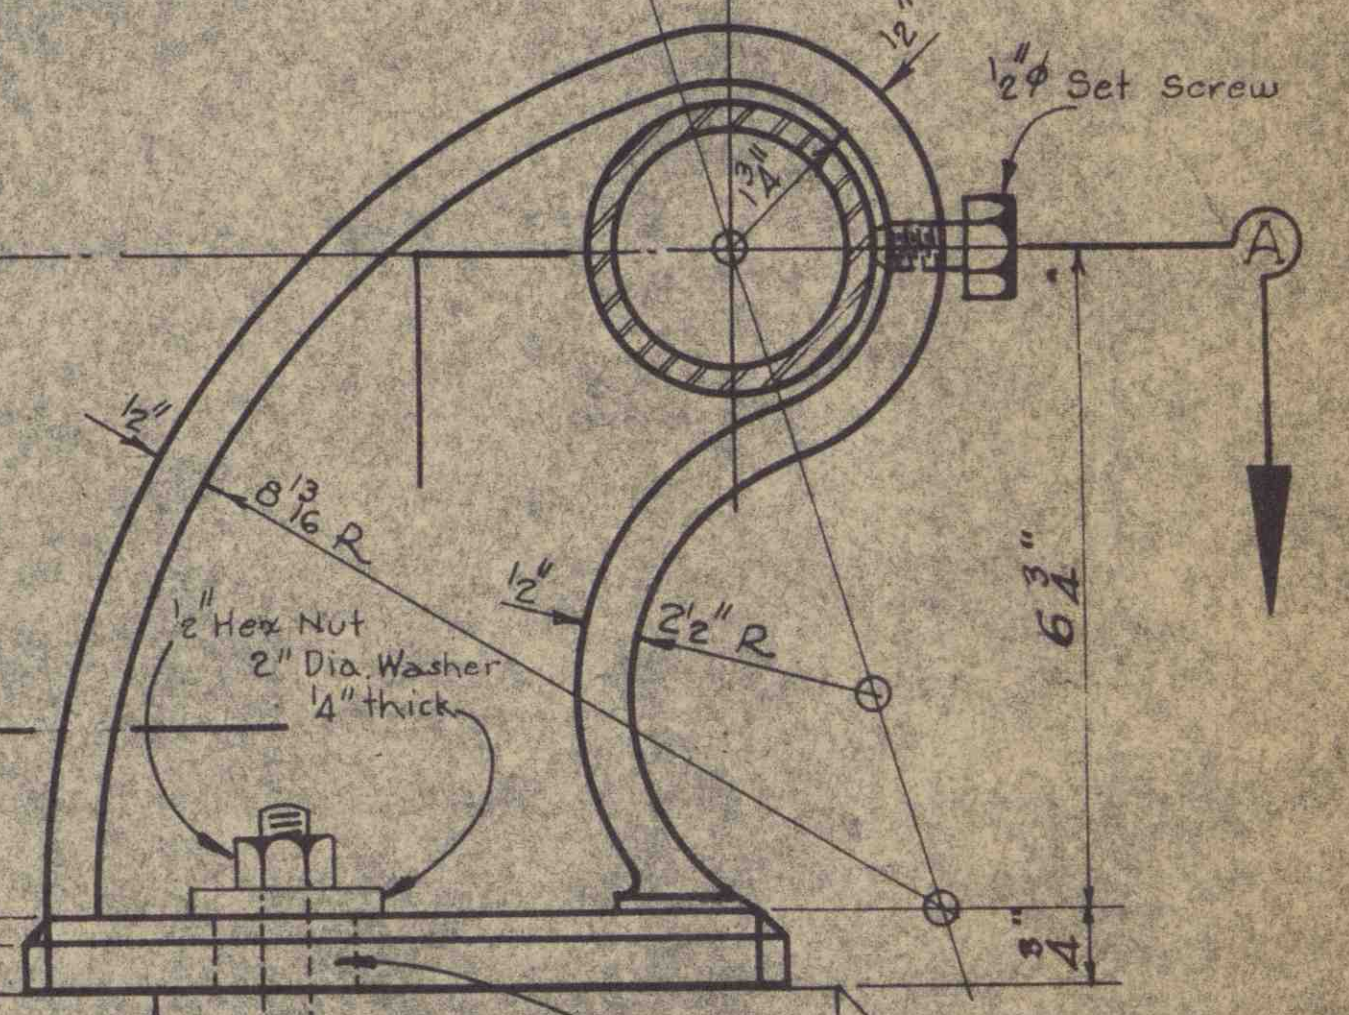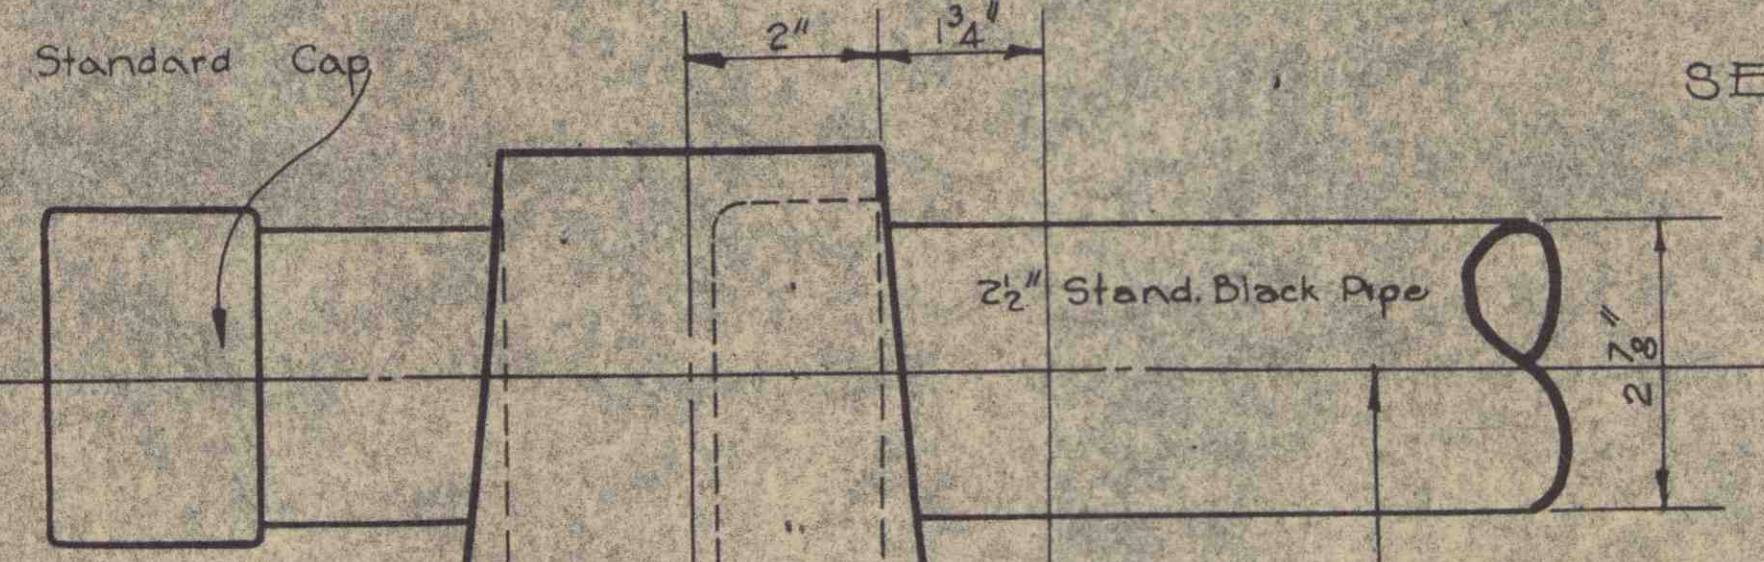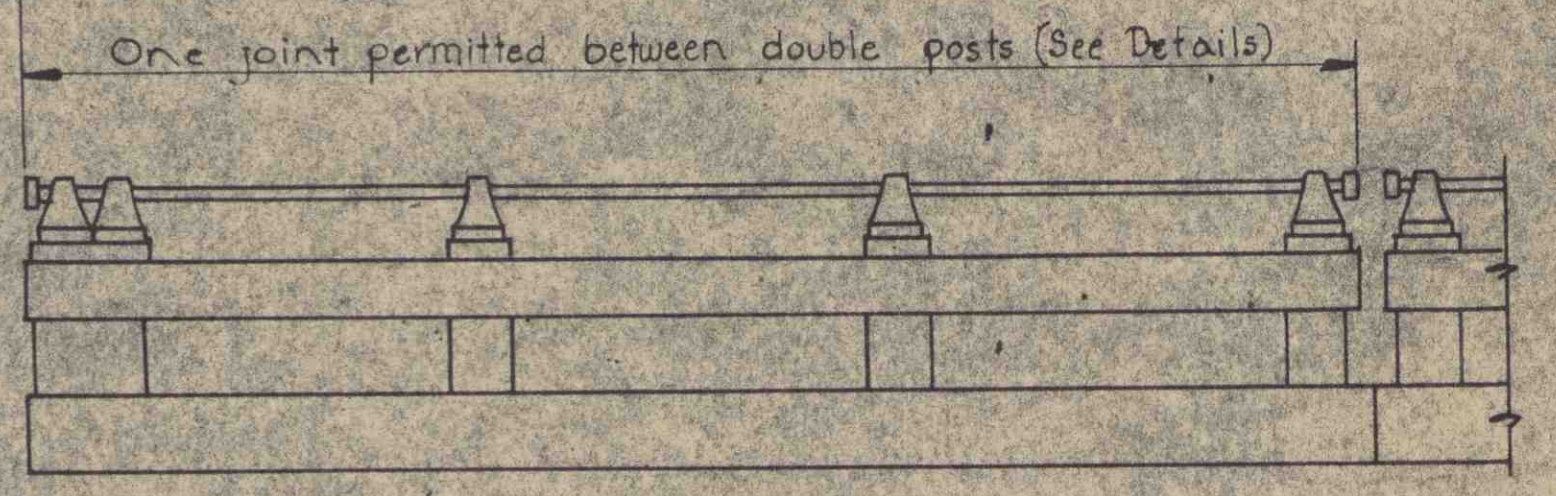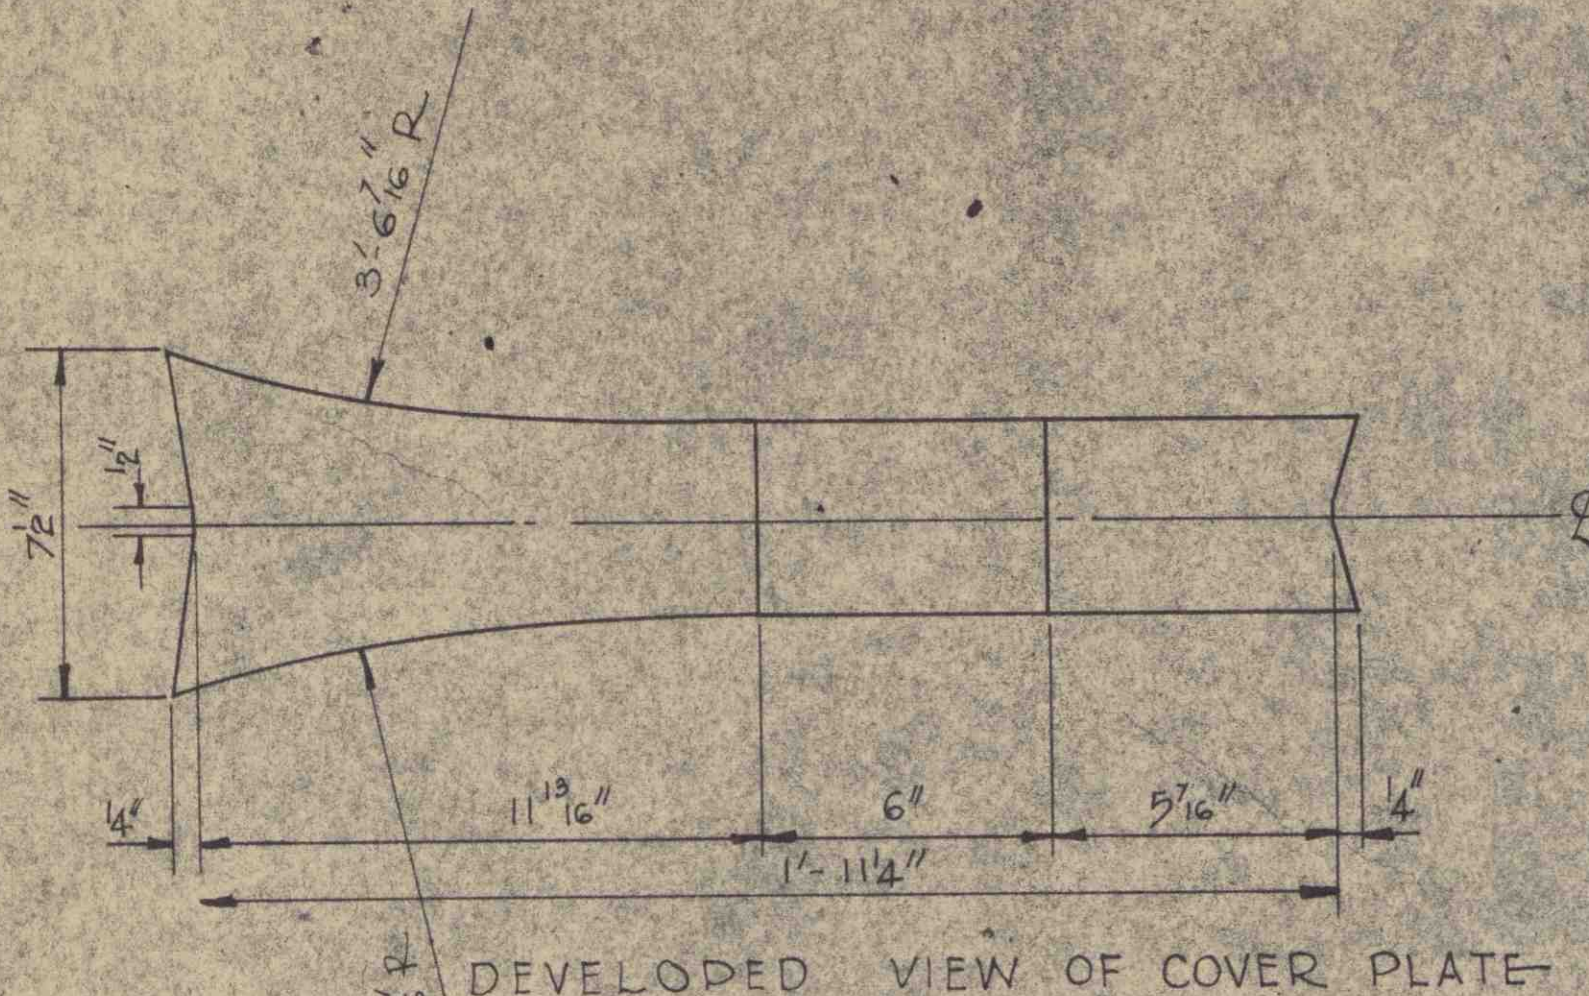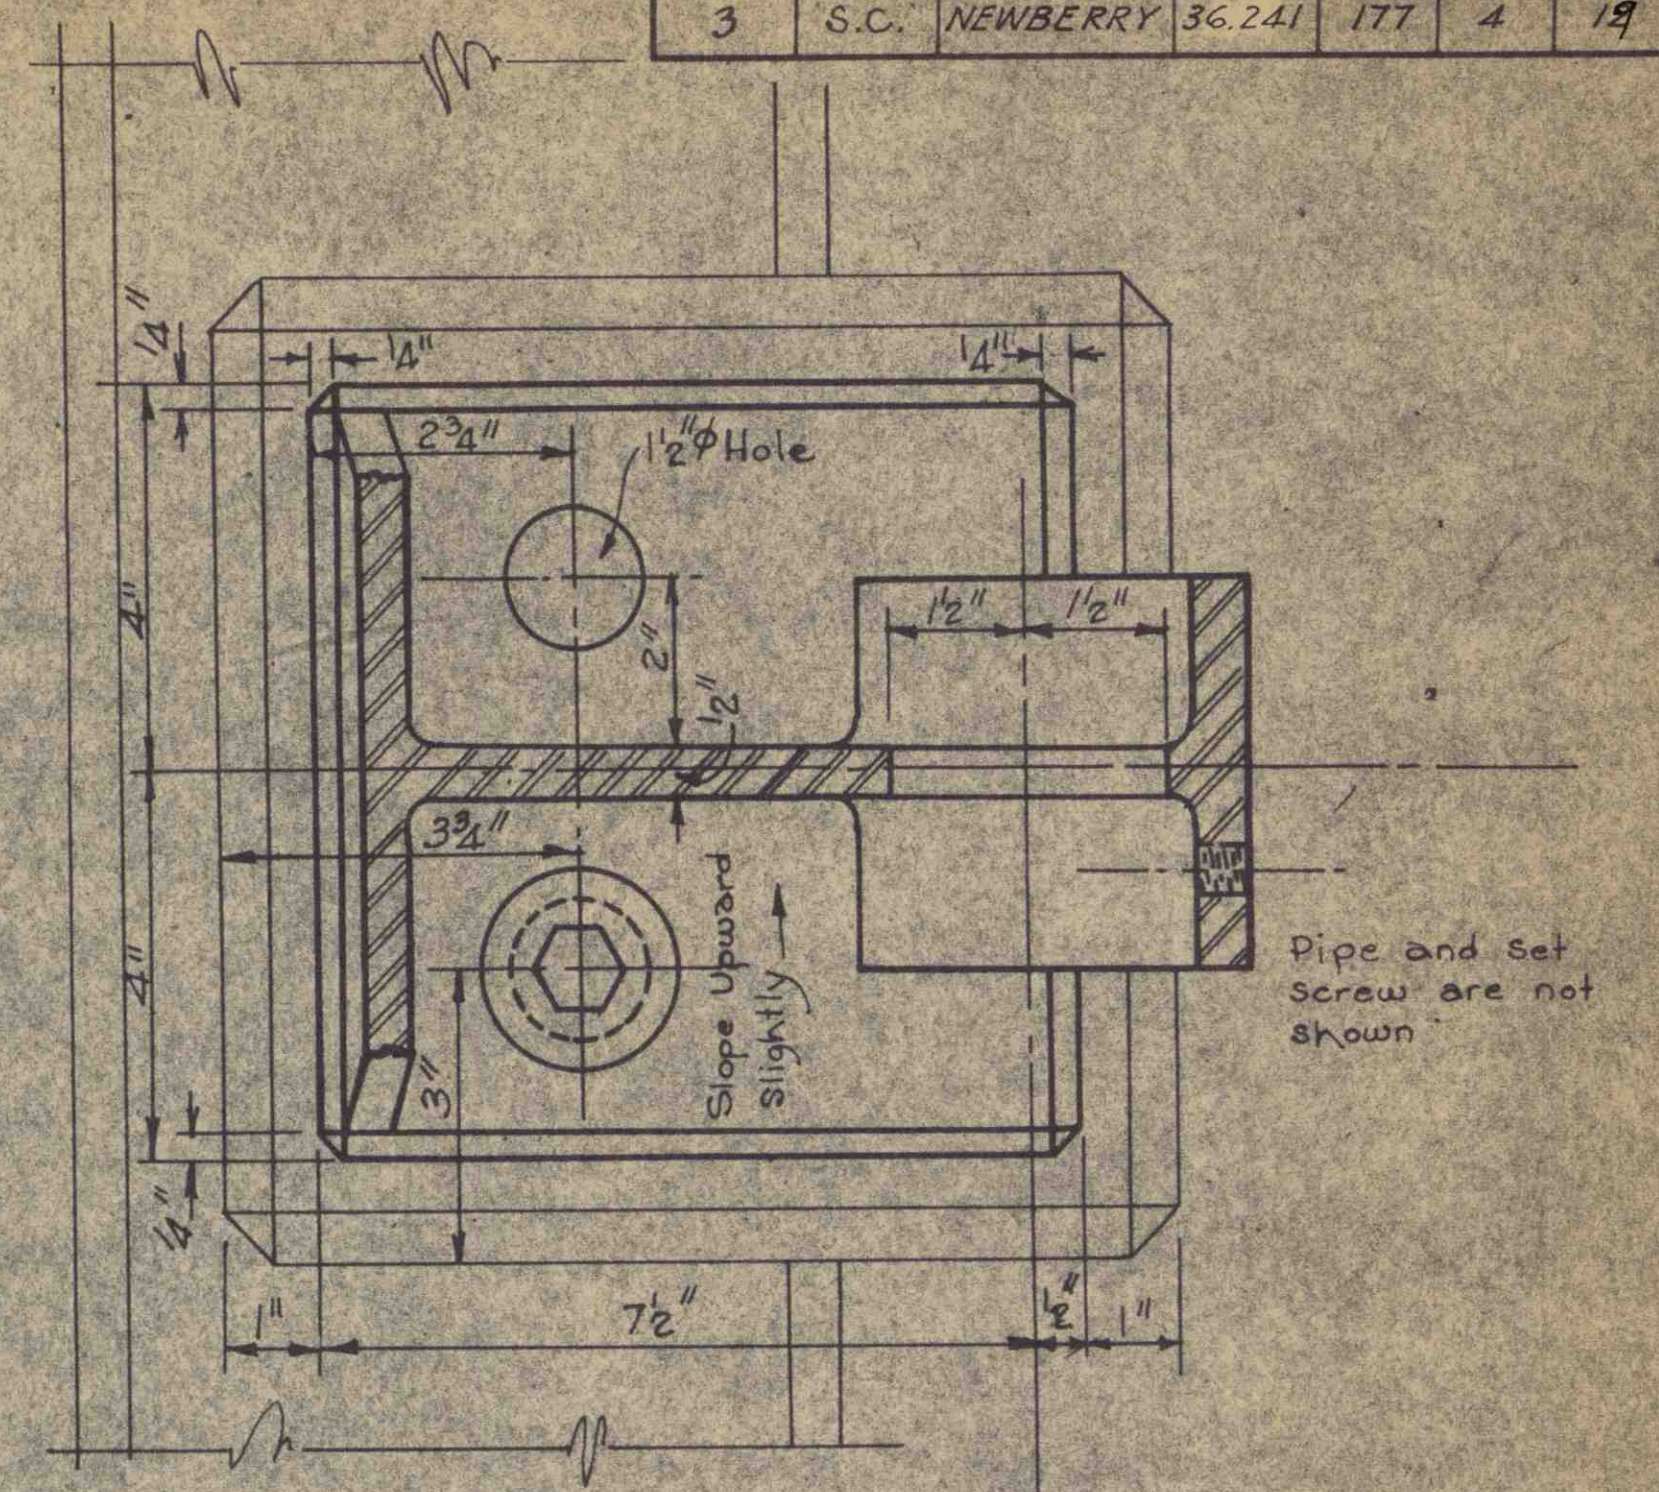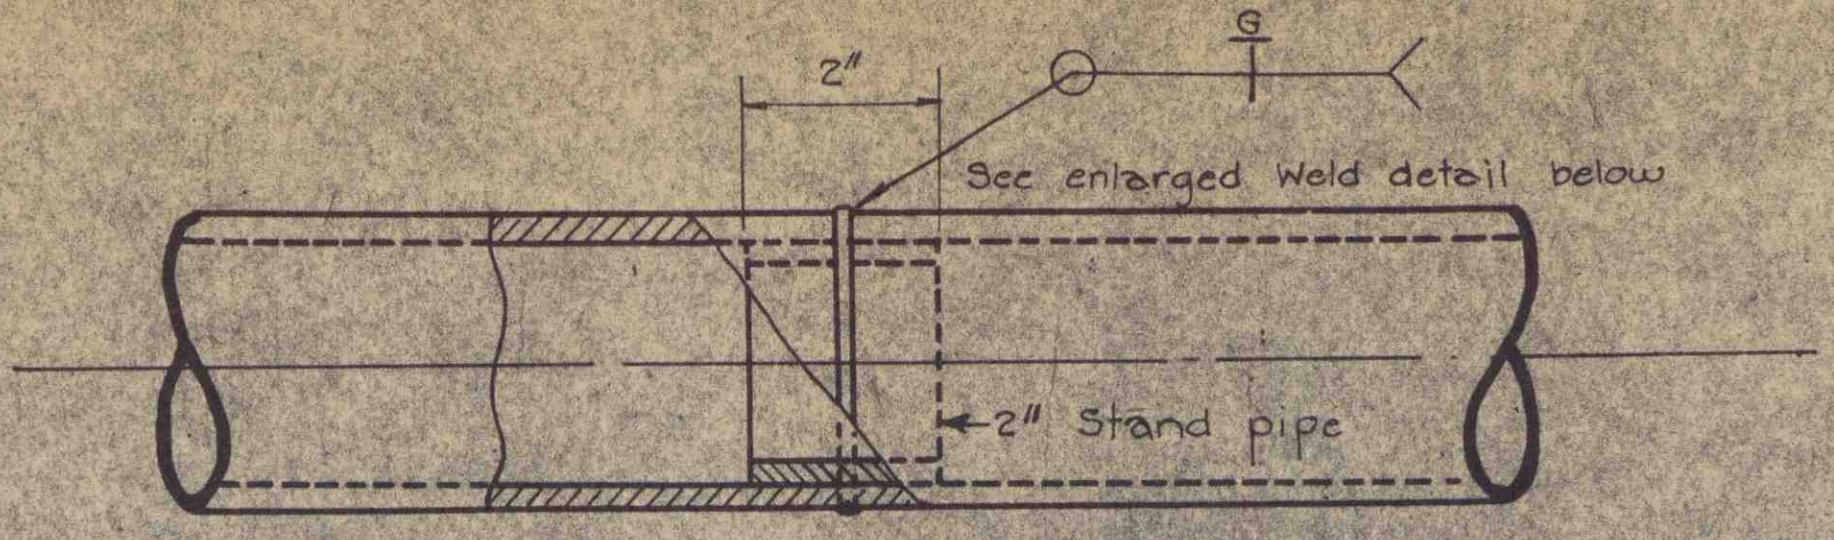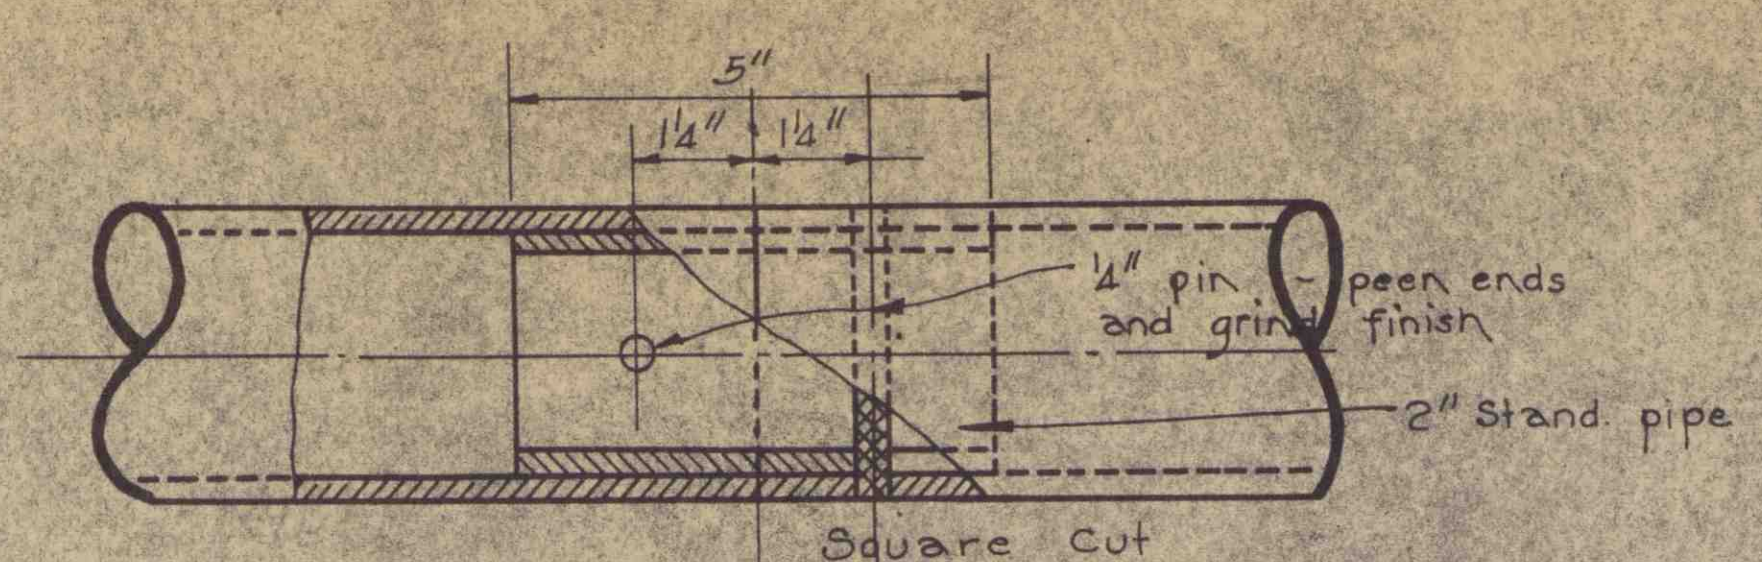

Details not shown shall be the same or as closely similar as practicable to those shown for Cast Iron Standard. Accessible welds shall be ground to a smooth surface. Omit duck between post top and standard.

Approx. Weight = 24 Lbs. Each.

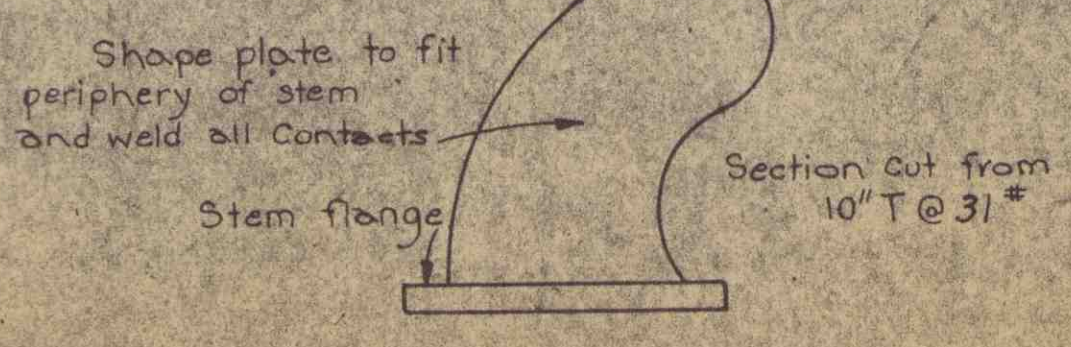

REV	W.R.T.	8-47
QUAN.		
TR.	W.R.T.	8-47
DR.	W.R.T.	8-47
DES.		
BY	CK'D	DATE


The Contractor may use either the Fabricated or Cast Iron Standard

DETAIL FOR CAST IRON BRACKET

S. C. STATE HIGHWAY DEPARTMENT
 COLUMBIA
 DETAILS OF PIPE RAILING
 FOR BRIDGE OVER
 CANNONS CREEK
 AND
 KINGS CREEK
 DOCKET NO. 36.241 ROUTE NO. 177
 COUNTY NEWBERRY DATE OCT. 1948

SEA. ROAD DIST. NO.	STATE	COUNTY	DOCKET NO.	ROUTE NO.	SHEET NO.	TOTAL SHEETS
3	N.C.	NEWBERRY	36 241	177	5	19


MRS. MAUDE J. PINNER
D 8-17-43
P.I. = 340+31.2 (No Ret.)
Δ = 15°-52' L.R.
D = 1°-00'
T = 798.4
L = 1586.7
E = 55.37

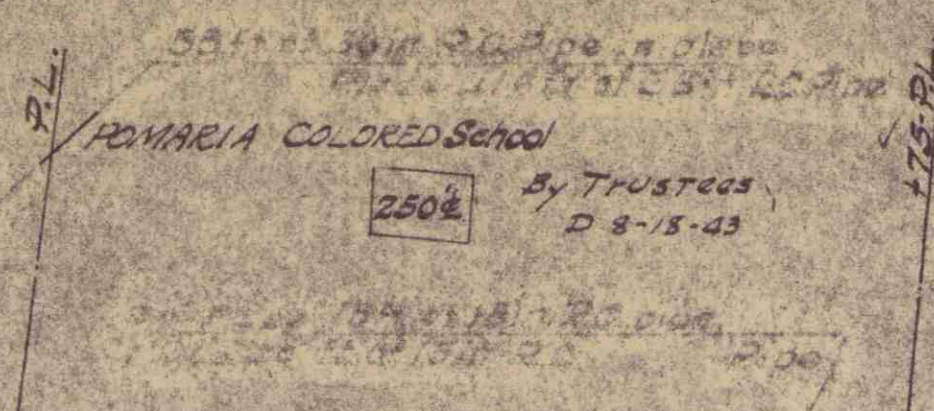

MRS. MAUDE J. PINNER
D 8-17-43
P.T. = 348+19.5

ANNIE L. JOHNSTON & W.D. HATTON
D 8-17-43
P.O.T. = 358+78.7

SLUBER EST.
By Individual Heirs
Deeds 7-25-43
10-5-43
12-12-43

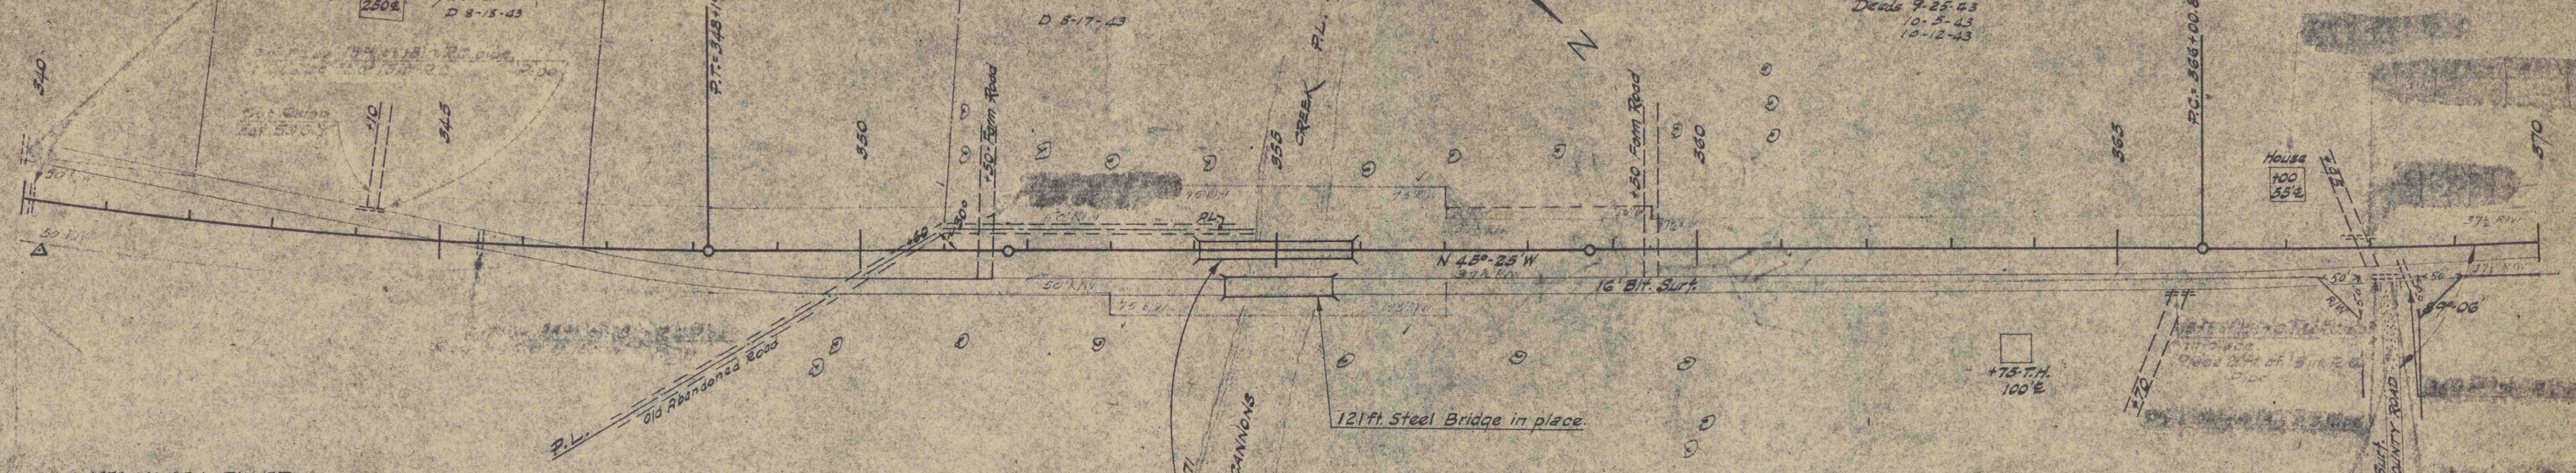

MRS. MAUDE J. PINNER
ASHEVILLE, N.C.
D-8-17-43

DE. R.J. JOHNSTON
ASHEVILLE, N.C.

Construct 180'-0" R.C. Bridge From
Sta. 354+00.0 to Sta. 355+90.0.


SLUBER EST.
By Individual Heirs
(See Above)

D. T. WICKER
D-8-5-43

B.M. - U.S.G.S. B.M. No. 625-45' ET OF
STA. 347+15 - EL. 312.187 - EL. 312.10
DOCKET No. 36,223

B.M. - NAIL IN SIDE OF 12" GUM
50' LT. STA. 354+18 EL. 290.29


B.M. - NAIL IN ROOT OF 20" PINE
35' LT. STA. 353+70 EL. 288.38

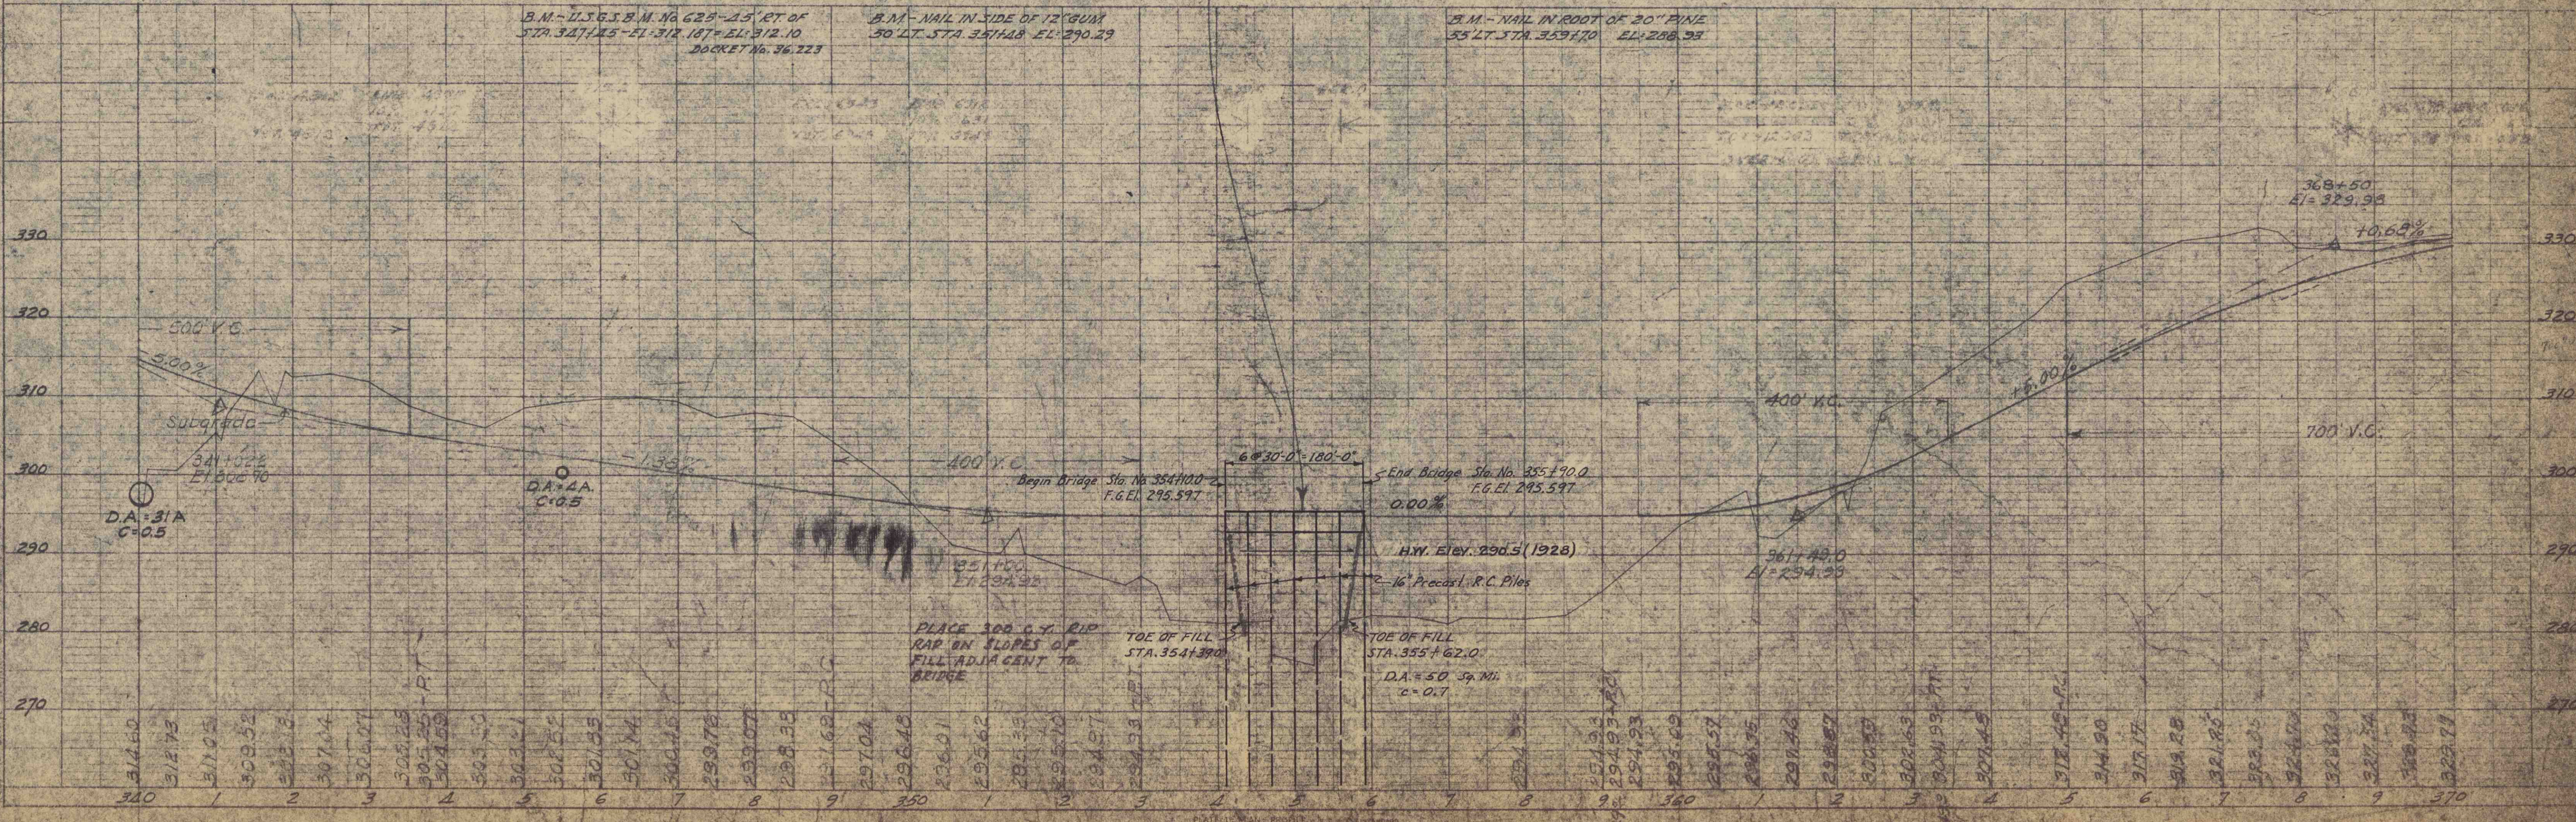

DATE: _____
SCALE: _____
PROJECT: _____
DRAWN BY: _____
CHECKED BY: _____

PROFILE: _____
SCALE: _____
PROJECT: _____
DRAWN BY: _____
CHECKED BY: _____


FED. ROAD DIV. NO.	STATE	COUNTY	DOCKET NO.	ROUTE NO.	SHEET NO.	TOTAL SHEETS
3	S.C.	NEWBERRY	36.241	177	6	19

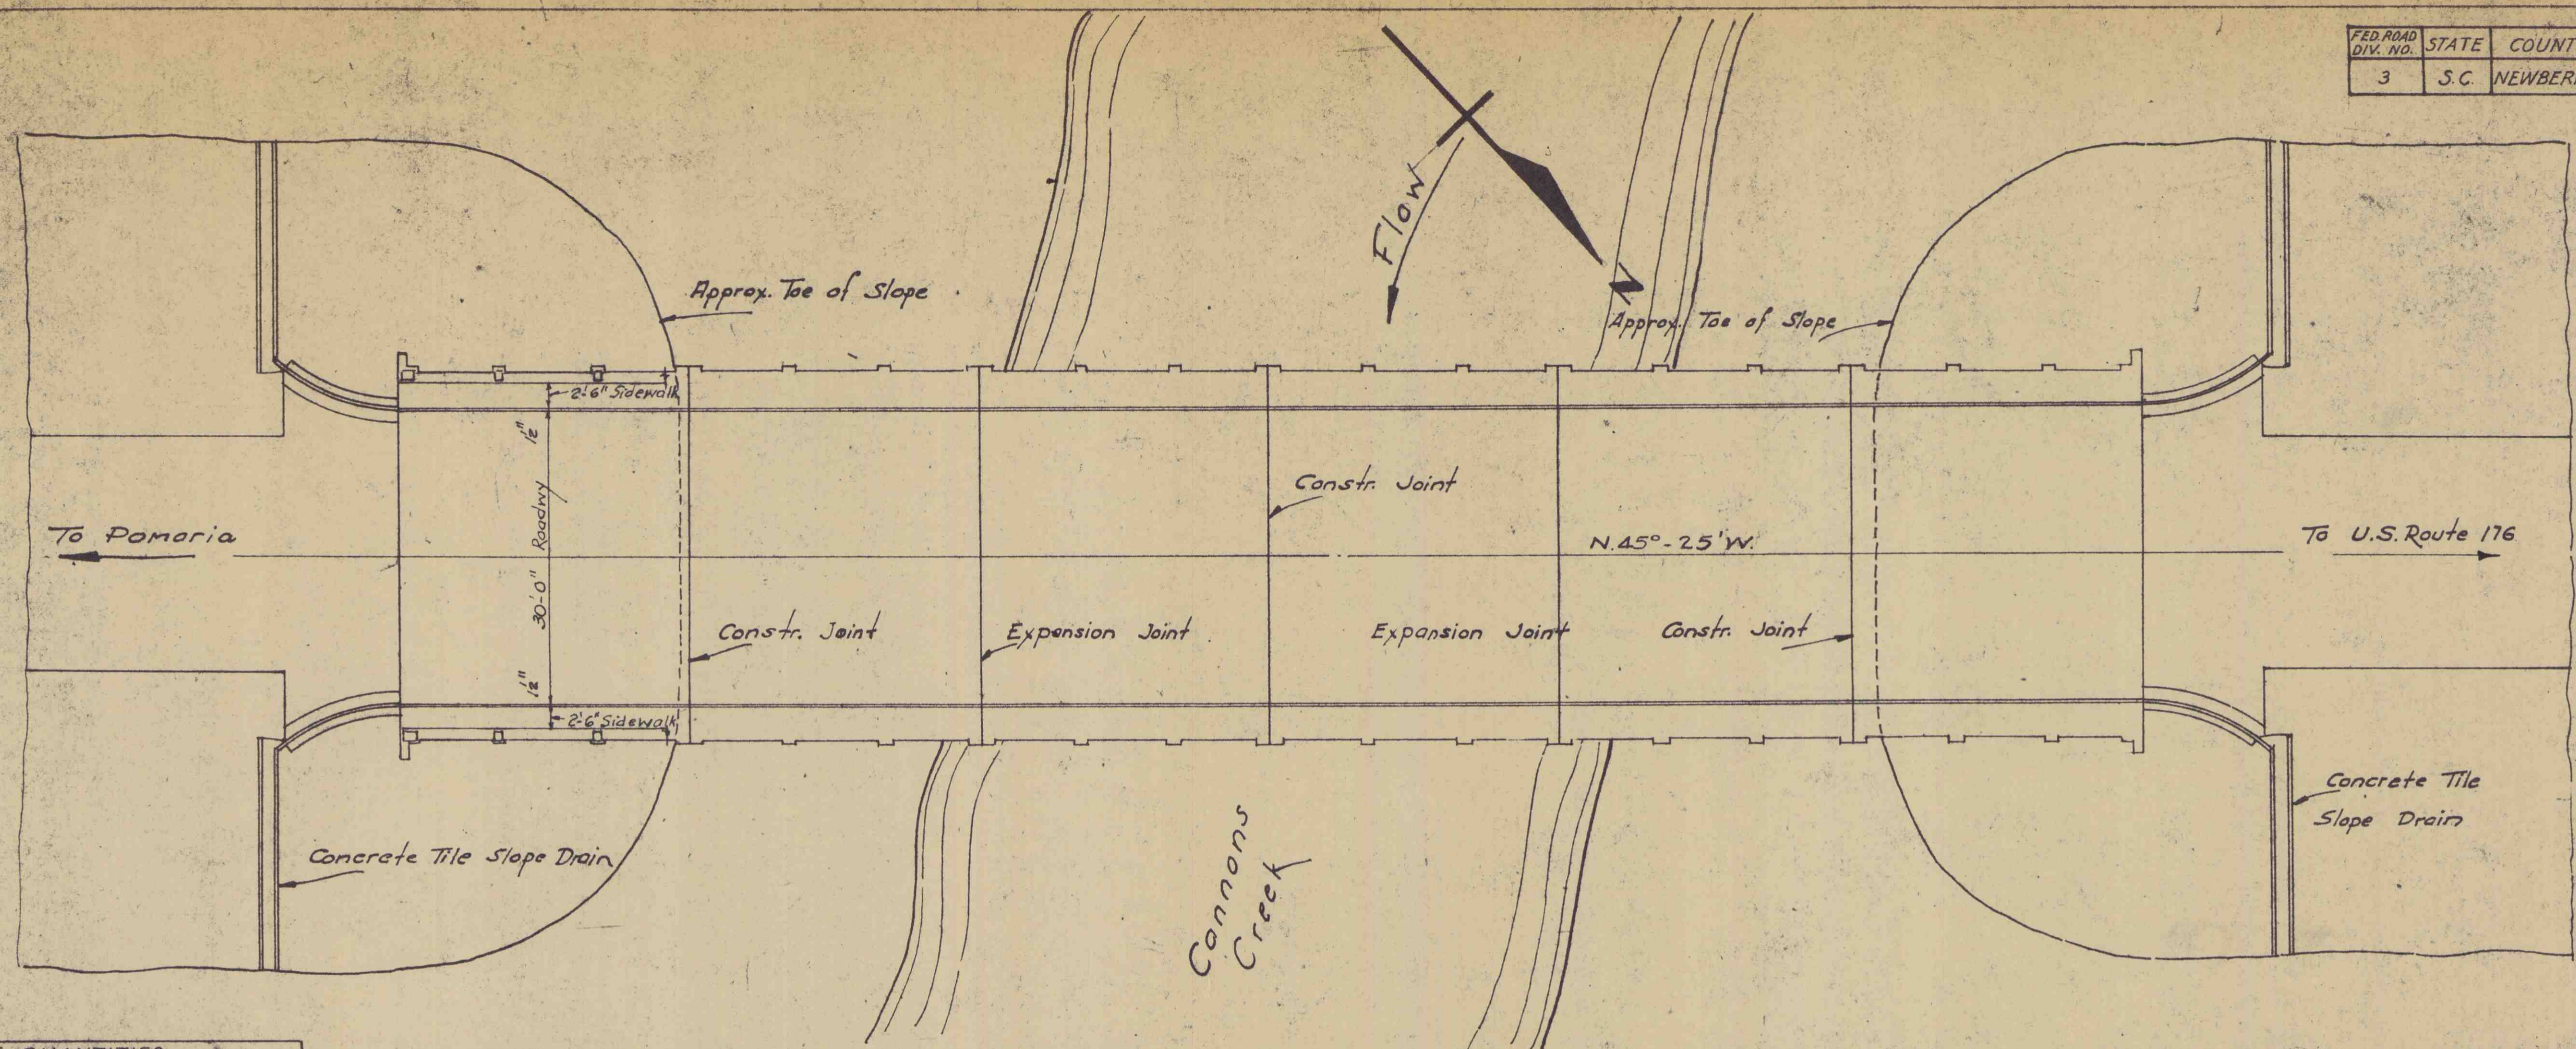

DATE: _____ BY: _____
 SURVEYED: _____
 PLOTTED: _____
 NOTE BOOK: _____
 NO. _____

DATE: _____ BY: _____
 SURVEYED: _____
 PLOTTED: _____
 NOTE BOOK: _____
 NO. _____

Bent No.	Reqd.	Class "A" Concrete C.Y.	Rein. Steel Lbs.	16" Pre-Cast Conc. Piling L.F.	Conc. Tile Slope Drain L.F.	Pipe Handrail L.F.
1	1	5.45	852	See Total	-	-
2	1	5.45	852	"	-	-
3	1	5.45	852	"	-	-
4	1	5.45	852	"	-	-
5	1	5.45	830	"	-	-
6	1	5.45	852	"	-	-
7	1	5.45	852	"	-	-
30' End Span	2	84.90	20,806	-	120	120
30' Int. Span	4	161.76	41,676	-	-	240
Fl. Curb & Gutter	2	2.24	-	-	-	-
Totals		287.05	68,424	995	120	360

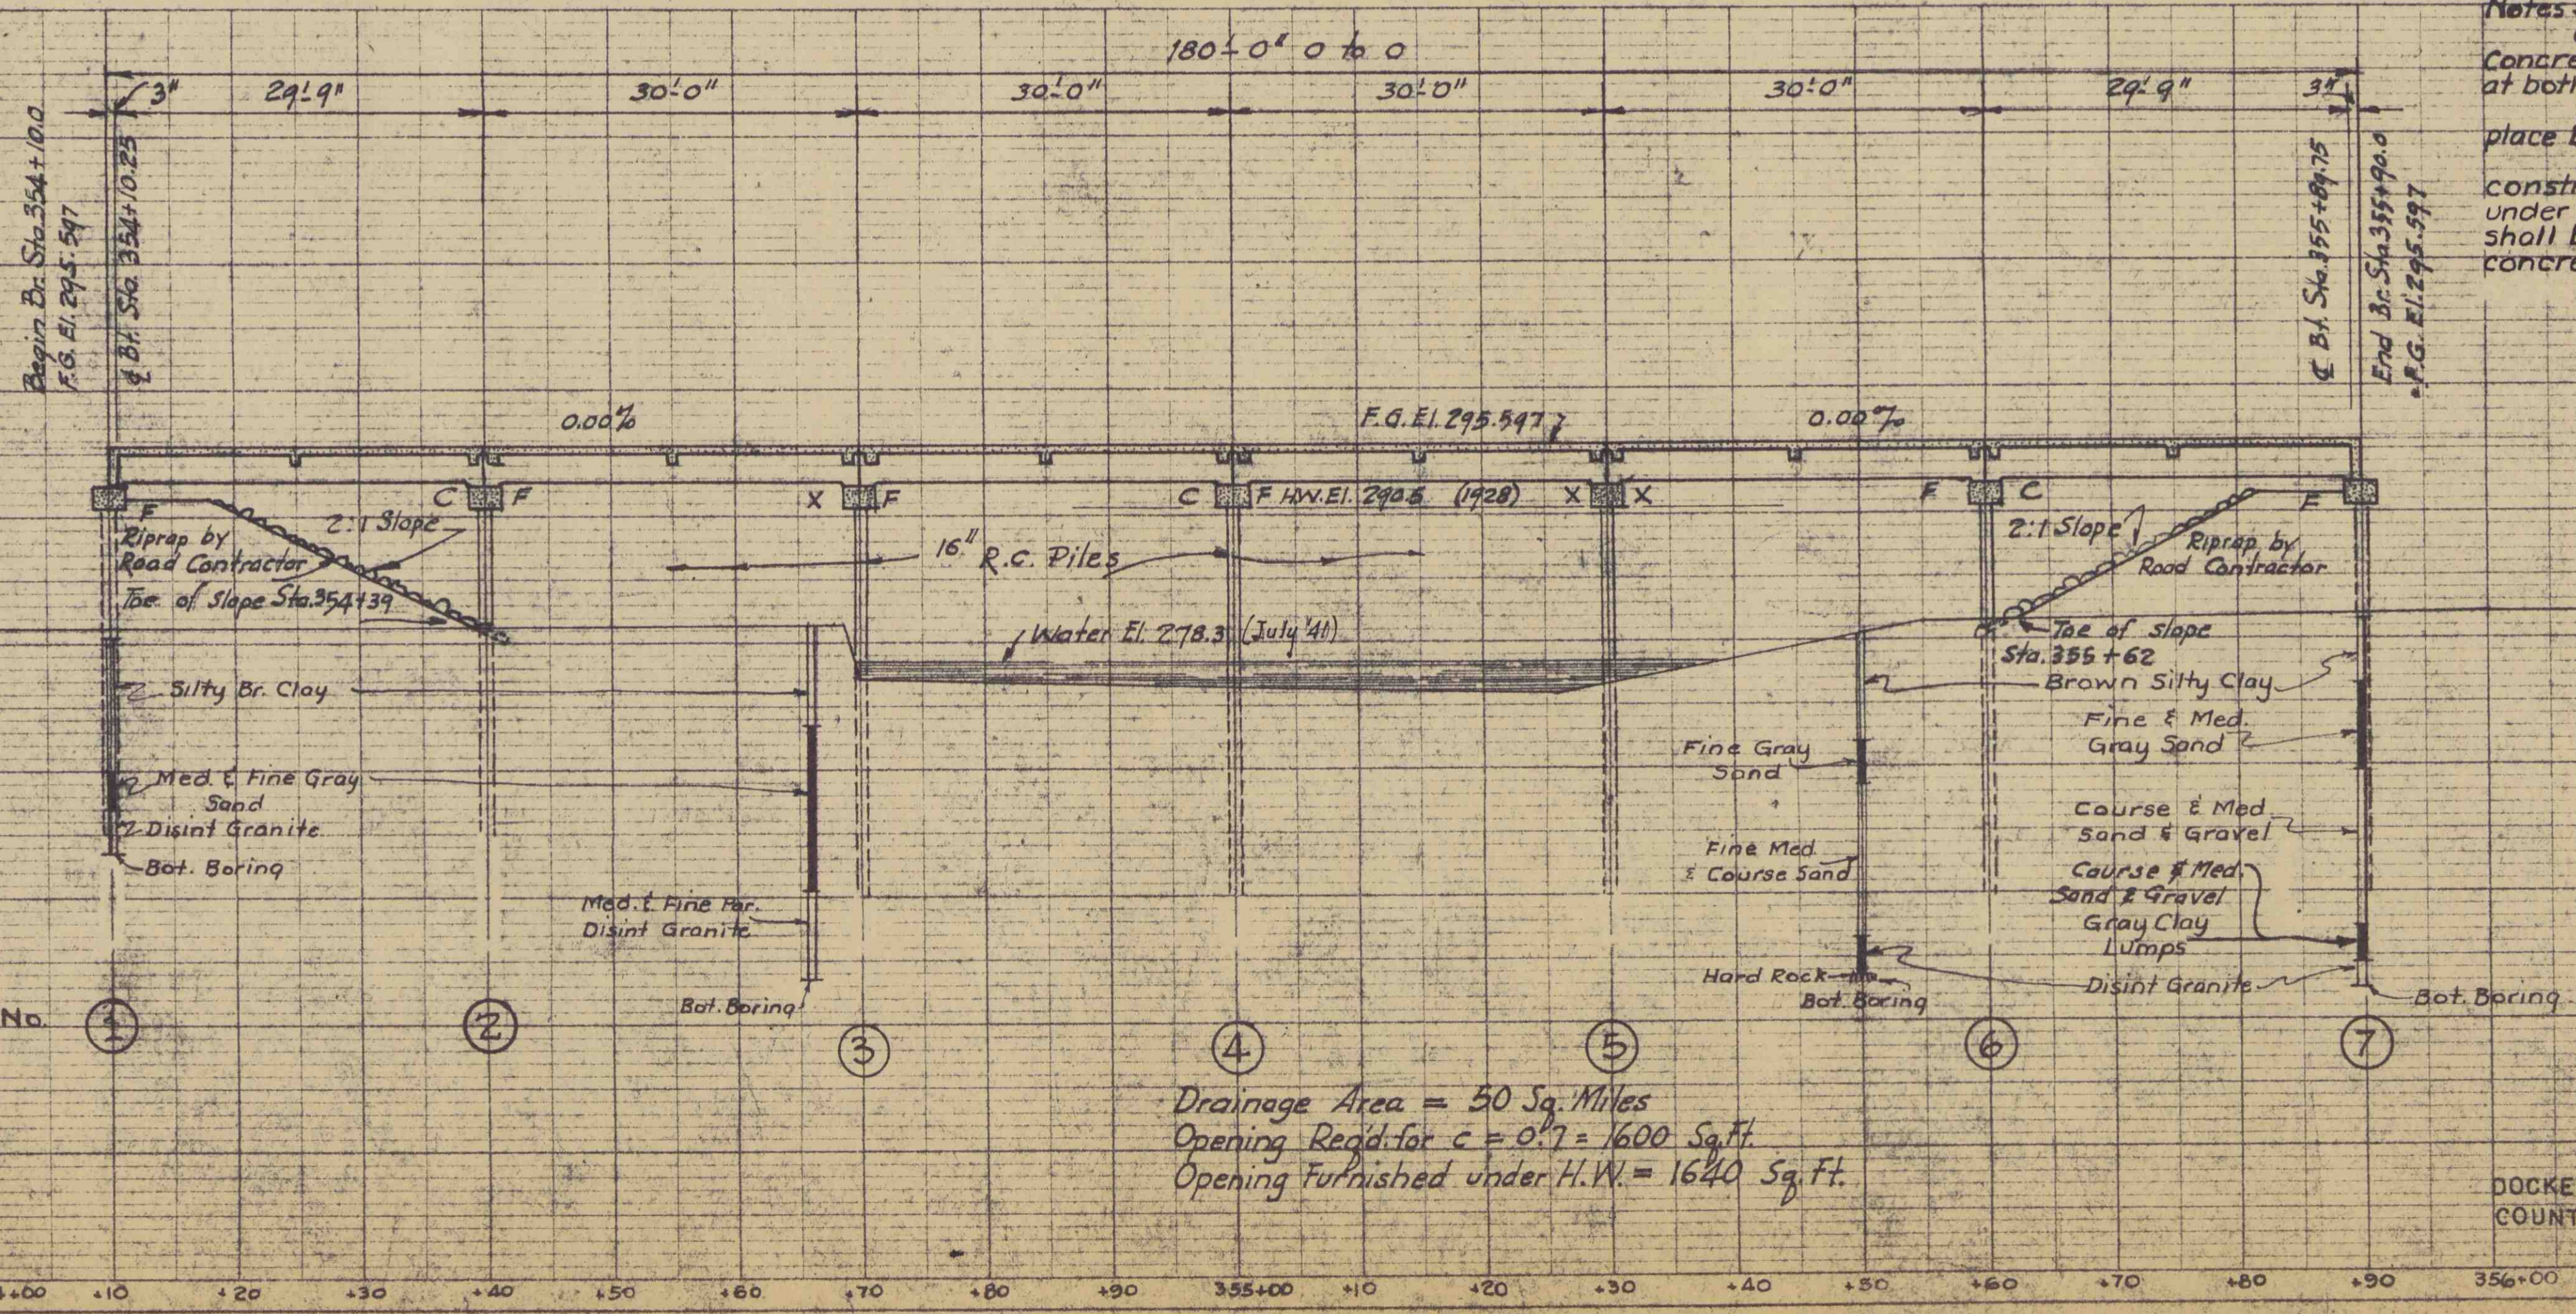


Notes -
 Construct Concrete Curb & Gutter and Concrete Tile Slope Drains on both sides of roadway at both ends of bridge.
 Fill at beginning and end of bridge to be in place before piles for end bents are driven.
 All cost of excavation necessary for construction of end bents and to remove fill under bridge down to 1' below top of End Bent Cap. shall be included in the Unit Price Bid for Class A concrete.

Drainage Area = 50 Sq. Miles
 Opening Req'd. for $c = 0.7 = 1600$ Sq. Ft.
 Opening Furnished under H.W. = 1640 Sq. Ft.

S. C. STATE HIGHWAY DEPARTMENT
 COLUMBIA
PLAN & PROFILE
 BRIDGE OVER
CANNONS CREEK

DOCKET NO. 36.241
 COUNTY - NEWBERRY
 ROUTE NO. 177
 OCTOBER 1948


FED. ROAD DIV. NO.	STATE	COUNTY	DOCKET NO.	ROUTE NO.	SHEET NO.	TOTAL SHEETS
3	S. C.	NEWBERRY	36.241	177	7	19

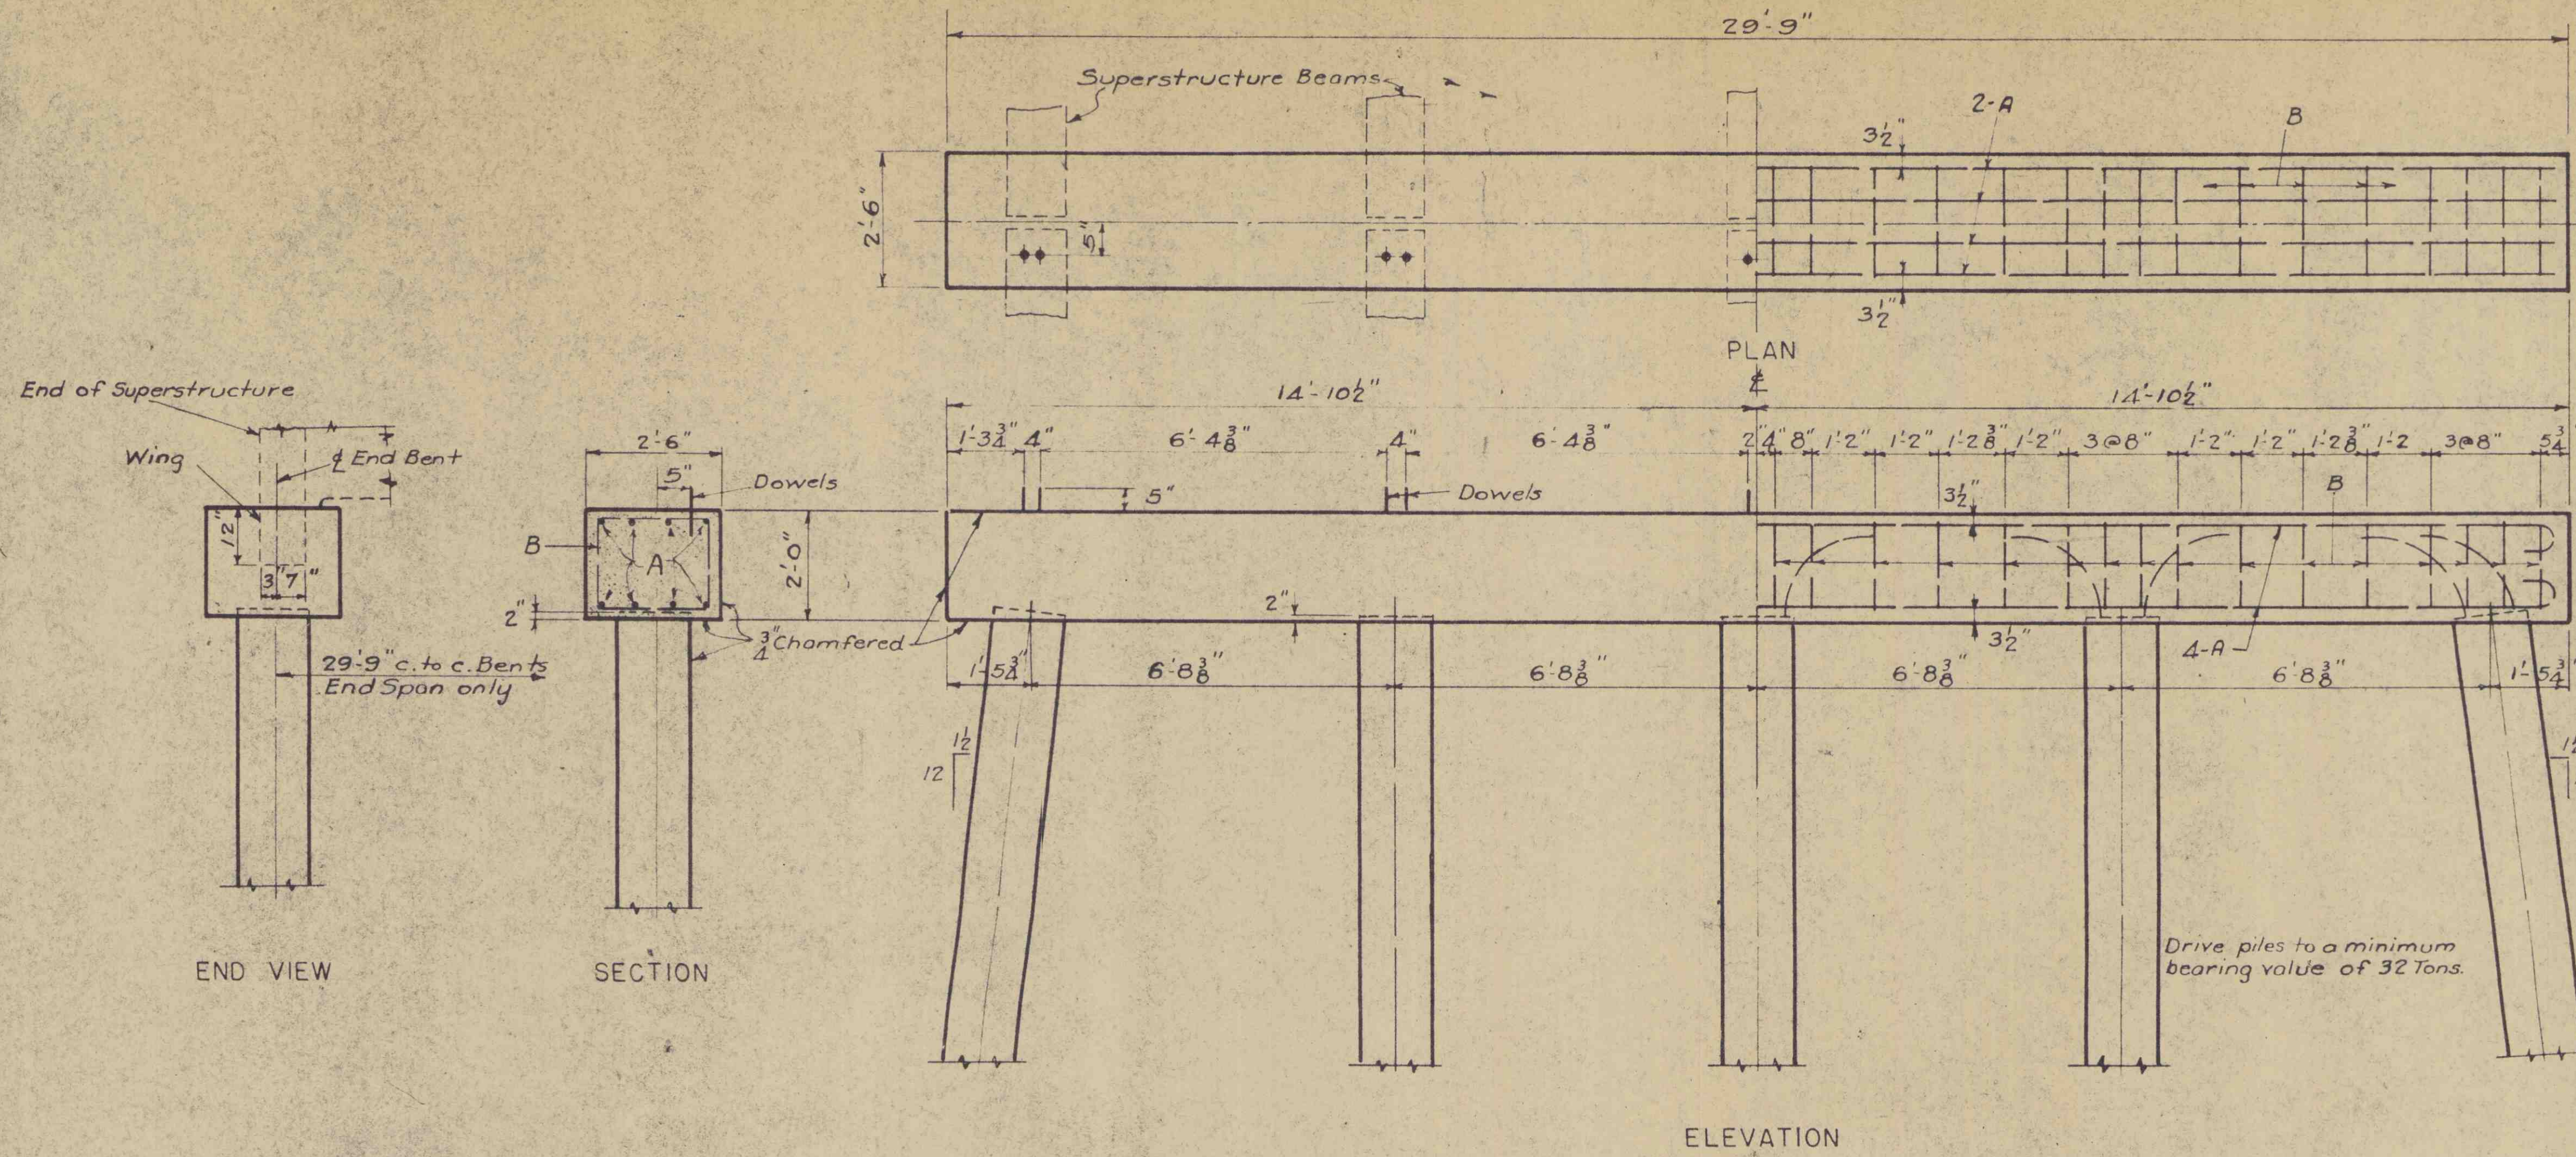

MARK	No.	SIZE	LENGTH	BENDING DETAILS
A	8	1"Ø	31'-3"	A 29'-3"
B	32	2"Ø	7'-8"	
* Dowels 10 1"Ø 0'-10"				B 1'-6" 2'-0"
CONC. CL. A 5.45 C.Y. REINF. STEEL *852 LBS				


* Deduct 10 Dowels (22 Lbs) for Bent No. 5.

1/2" 2 1/2" 1/2" and smaller Bars add 6" per hook.
2 3/4" 5/8" 3/4" Bars add 8" per hook.
3 1/2" 1/2" and larger Bars add 12" per hook.

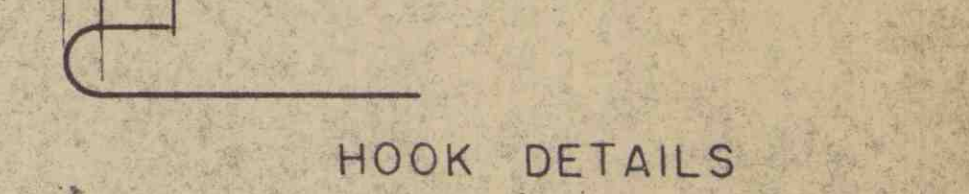

Notes:
All concrete to be Class "A".
All exposed edges to be chamfered 3/4" unless otherwise noted.

QUANTITIES FOR 40'-0" PILE
Concrete = 2.560 C.Y. Reinforcing Steel = 690 Lbs.
For Quantities for lengths greater or less than 40'-0"
add or subtract 0.066 C.Y. of Concrete and 17.18 Lbs.
of Reinforcing Steel.

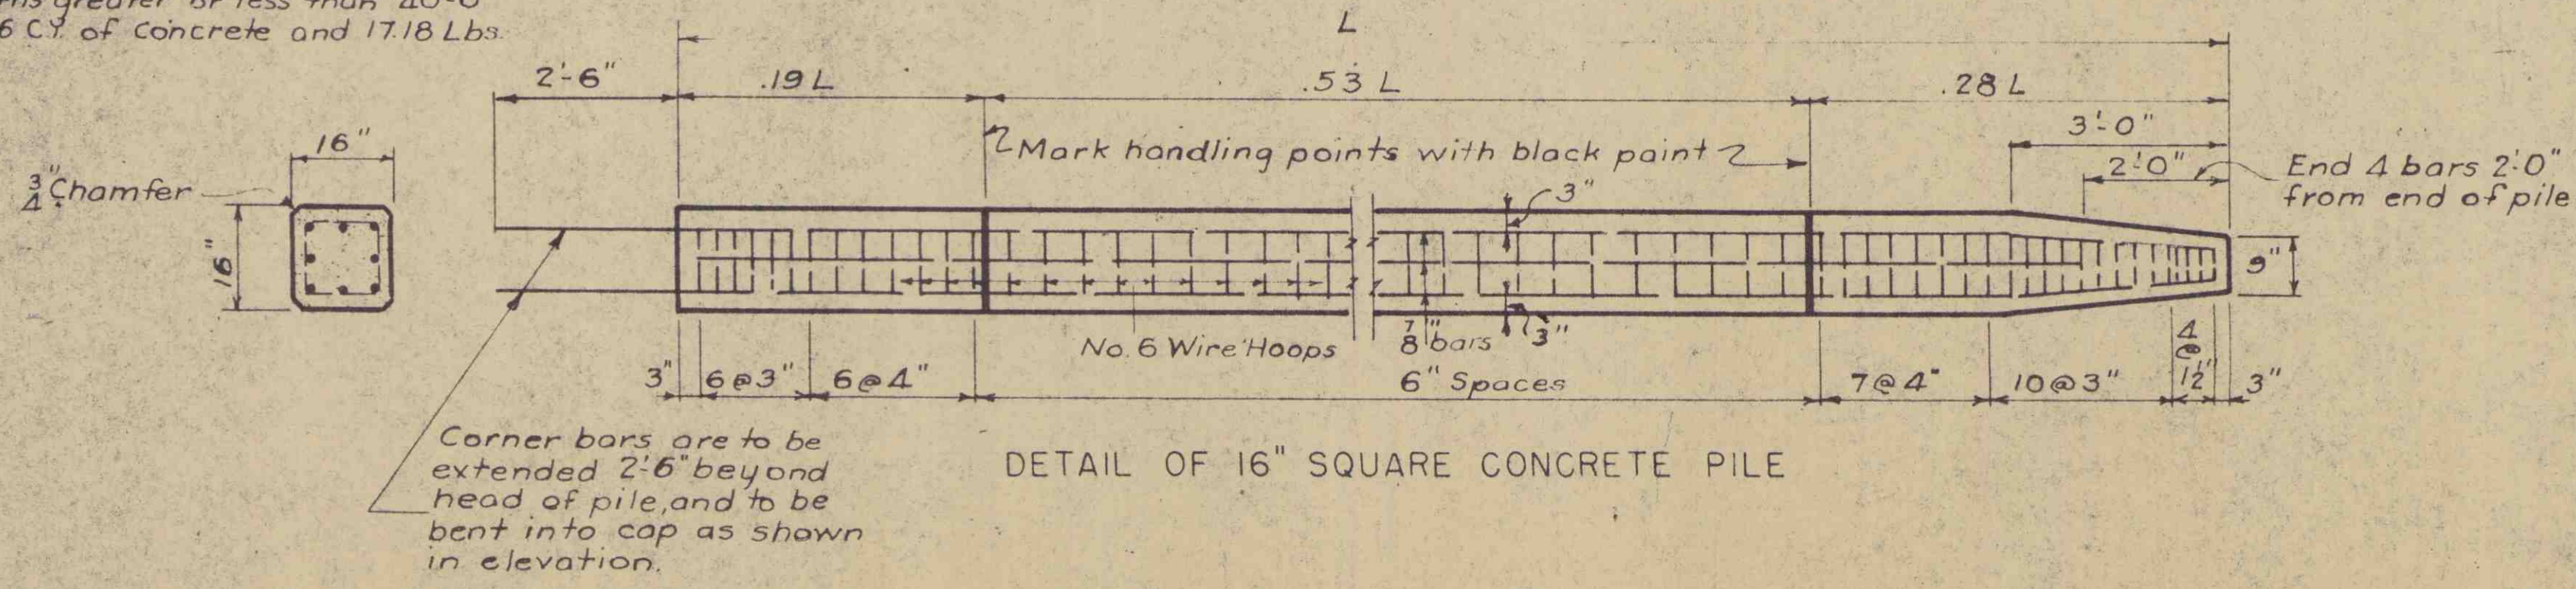

Rev.	R.W.H. B.M.C. 10-48
	For Dock. 36.241
Quan.	E.W.G. B.M.C. 10-48
Traced	E.W.G. B.M.C. 10-48
Dwn.	E.W.G. B.M.C. 10-48
Des.	W.E.C. B.M.C. 10-48
By	Ch'd Date



S. C. STATE HIGHWAY DEPARTMENT
COLUMBIA

BENT FOR 30' SPAN
FOR BRIDGE OVER
CANNONS CREEK

DOCKET NO. 36.241 ROUTE NO. 177
COUNTY NEWBERRY DATE OCT. 1948

16" R.C. PILE BENT C30-30-2.5 1948

FED. ROAD DIV. NO.	STATE	COUNTY	DOCKET No.	ROUTE NO.	SHEET No.	TOTAL SHEETS
3	S.G.	NEWBERRY	36.241	177	8	19

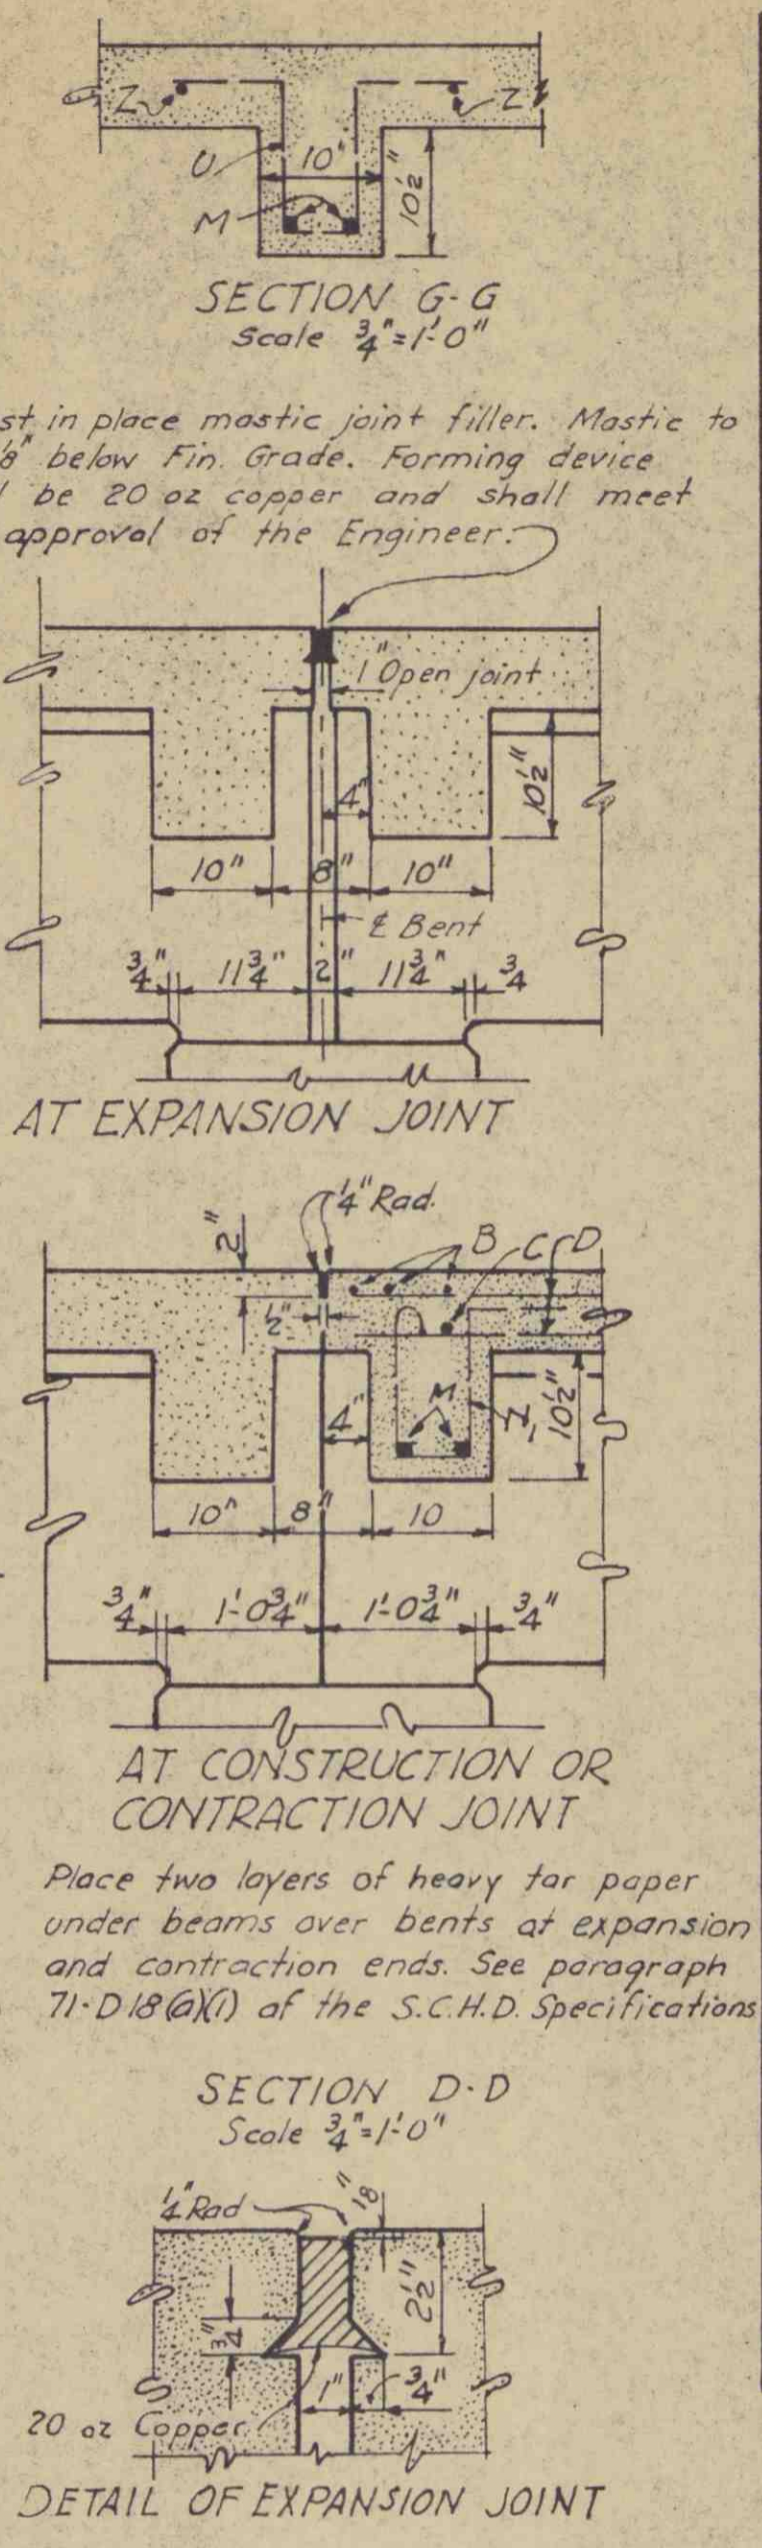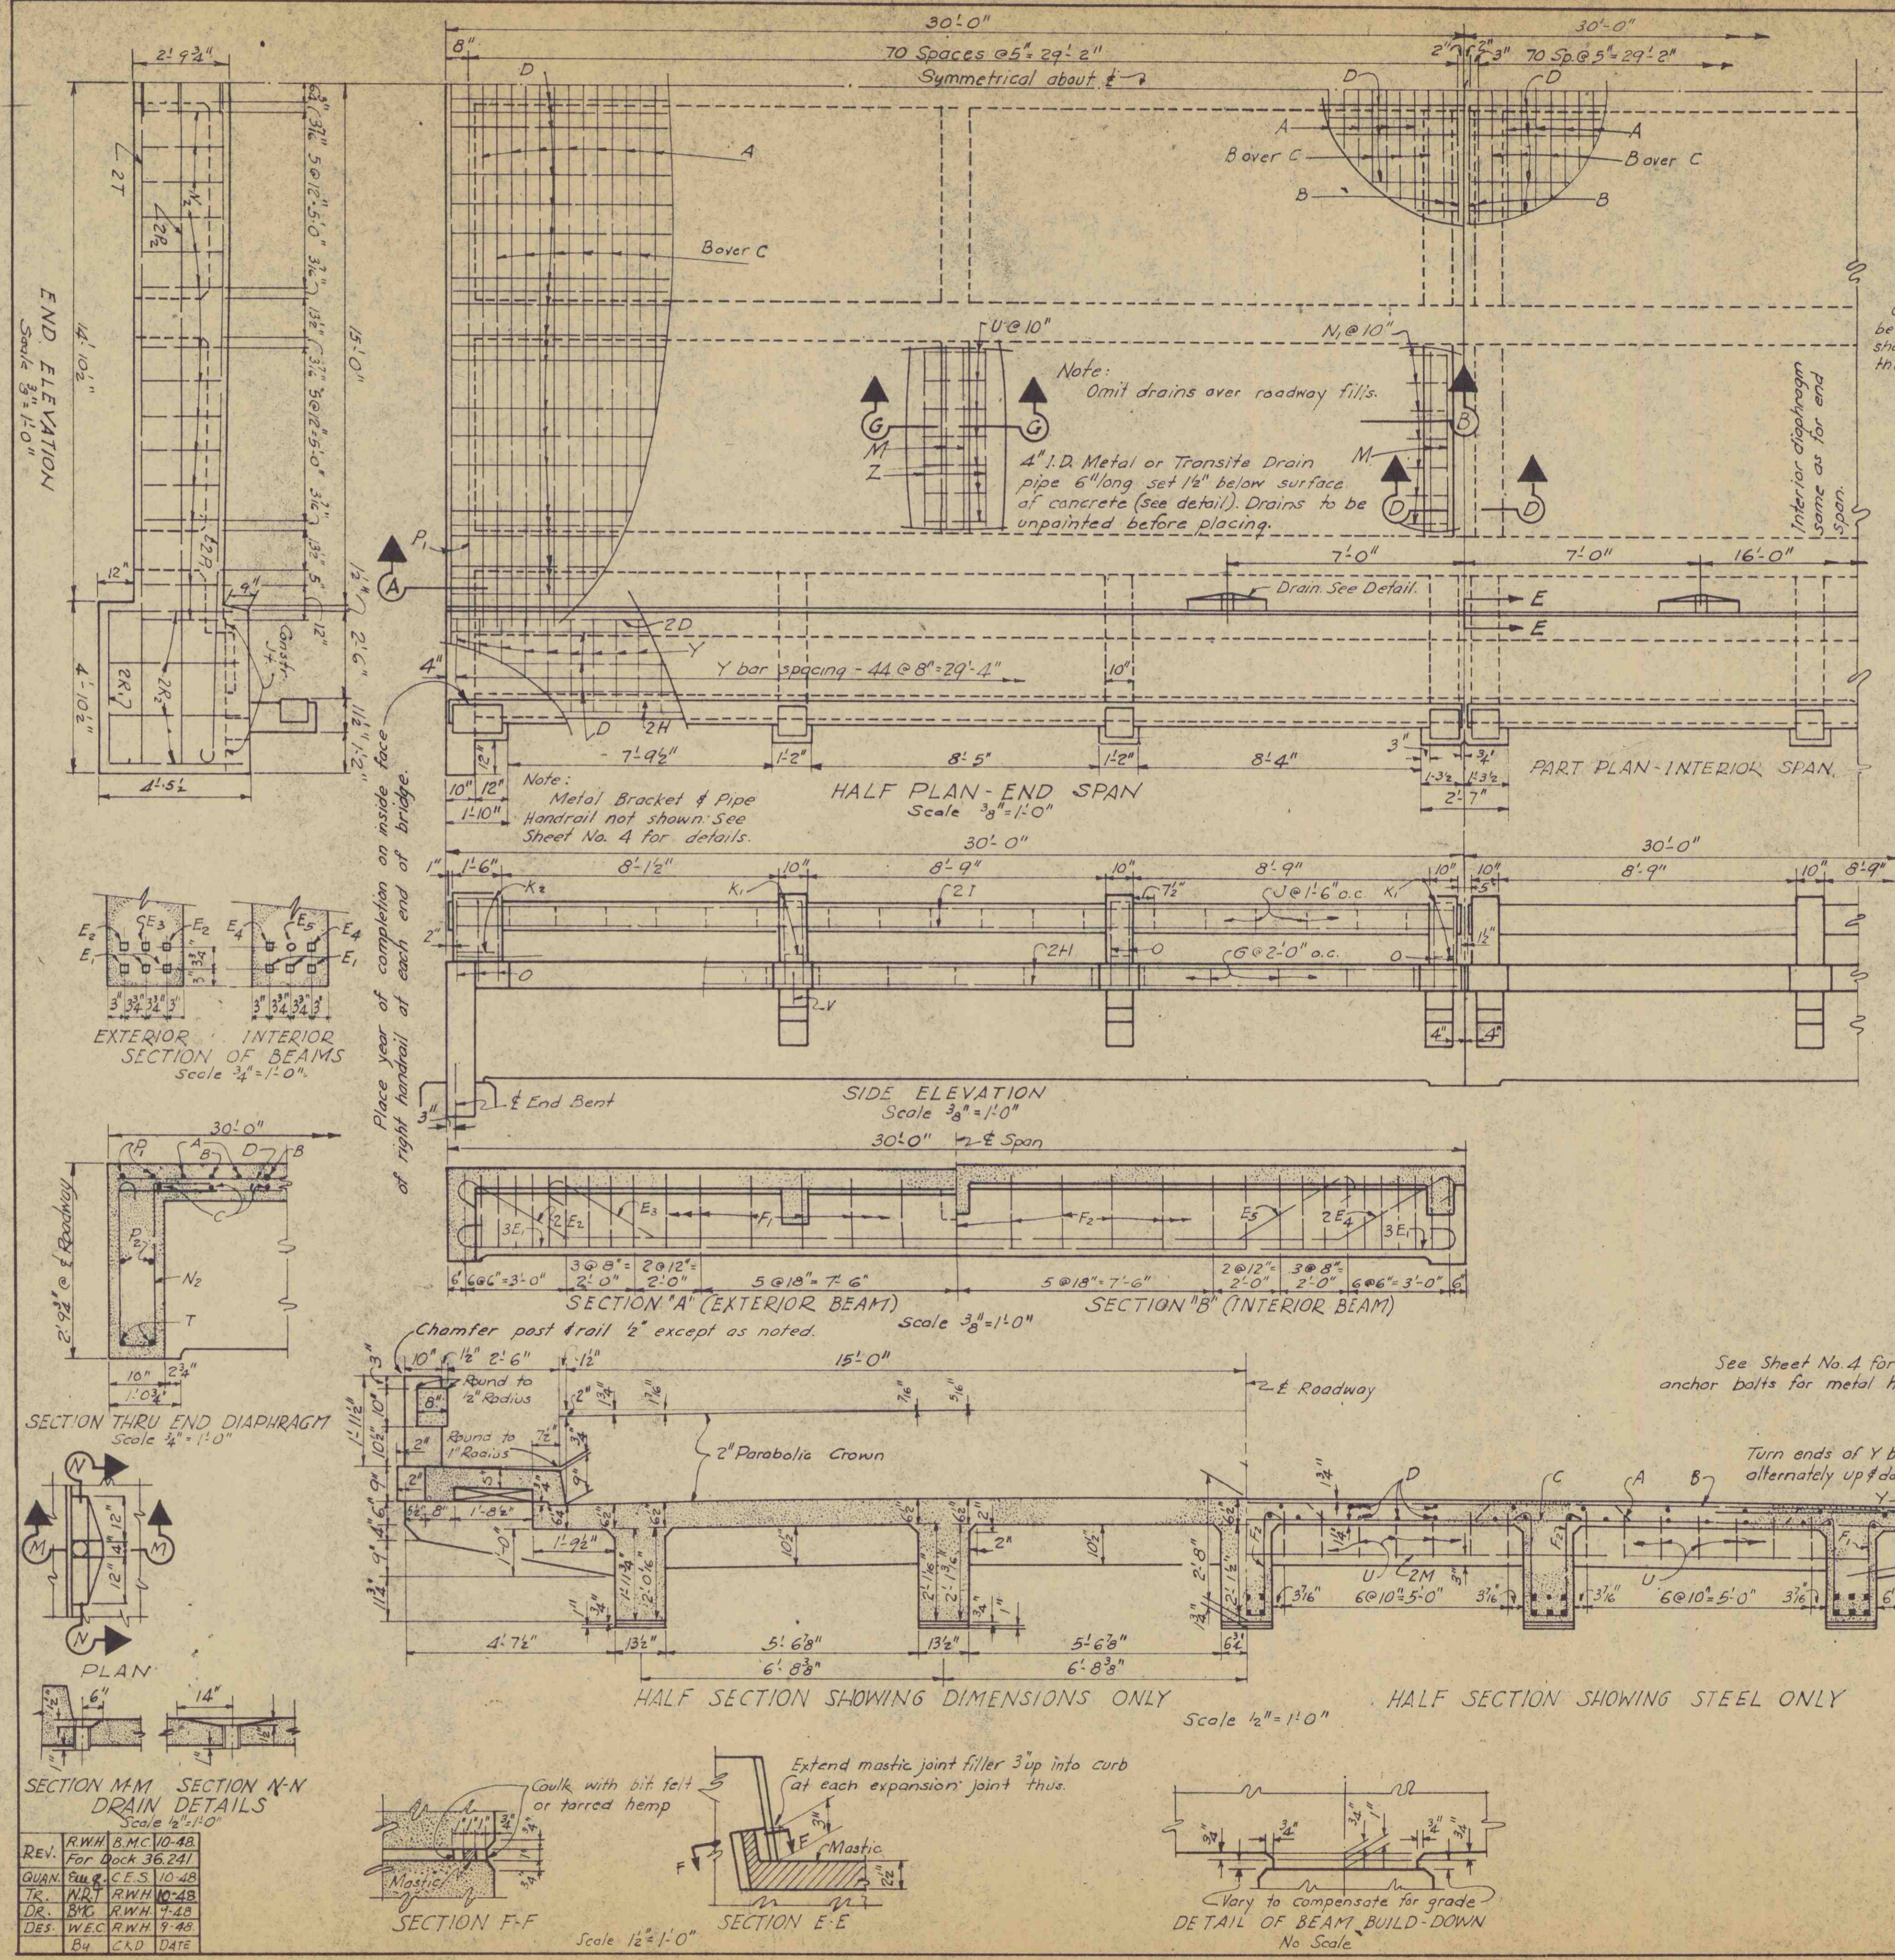

STEEL SCHEDULE								BENDING DETAILS	
ONE INTERIOR SPAN								Symm about E-Z	
Mark	Size	No	Length	D	Mark	Size	No	Length	D
A	1/2"	34	33'-2"	B	Lc	1/2"	8	2'-10"	B
B	1/2"	39	32'-2"	B	L3	1/2"	8	3'-0"	B
C	1/2"	35	33'-2"	B	L4	1/2"	8	3'-2"	B
D	1/2"	62	29'-8"	S	L5	1/2"	8	3'-5"	B
E1	1/4"	15	31'-4"	B	L6	1/2"	8	3'-8"	B
E2	1/8"	4	31'-11"	B	L7	1/2"	8	3'-11"	B
E3	1/4"	2	26'-6"	B	M	1"	6	27'-6"	S
E4	1/8"	6	32'-0"	B	N1	1/2"	56	3'-9"	B
E5	1"	3	26'-1"	B	O	1/2"	16	6'-6"	B
F1	1/2"	66	5'-11"	B	S1	3/4"	16	8'-8"	B
F2	1/2"	99	6'-3"	B	S2	3/4"	16	5'-0"	S
G	1/2"	30	2'-4"	B	U	1/2"	28	4'-0"	B
H	1/2"	8	29'-8"	S	V	3/4"	8	0'-10"	S
I	1/2"	8	29'-8"	S	Y	3/8"	90	2'-10"	B
J	1/2"	36	2'-6"	B	Z	1/2"	2	25'-11"	S
K1	1/2"	16	2'-10"	B					
L1	1/2"	8	2'-8"	B					

ONE END SPAN									
Mark	Size	No	Length	D	Mark	Size	No	Length	D
A	1/2"	34	33'-2"	B	Lc	1/2"	6	3'-8"	B
B	1/2"	36	32'-2"	B	L7	1/2"	6	3'-11"	B
C	1/2"	35	33'-2"	B	M	1"	4	27'-6"	S
D	1/2"	62	29'-8"	S	N1	1/2"	28	3'-9"	B
E1	1/4"	15	31'-4"	B	N2	1/2"	28	6'-5"	B
E2	1/8"	4	31'-11"	B	O	1/2"	18	6'-6"	B
E3	1/4"	2	26'-6"	B	P1	1/2"	4	21'-1"	B
E4	1/8"	6	32'-0"	B	P2	1/2"	4	20'-7"	S
E5	1"	3	26'-1"	B	R1	1/2"	4	4'-6"	S
F1	1/2"	66	5'-11"	B	R2	1/2"	16	4'-0"	S
F2	1/2"	99	6'-3"	B	S1	3/4"	12	8'-8"	B
G	1/2"	30	2'-4"	B	S2	3/4"	12	5'-0"	S
H	1/2"	8	29'-8"	S	T	3/4"	4	20'-10"	S
I	1/2"	8	29'-8"	S	U	1/2"	28	4'-0"	B
J	1/2"	36	2'-6"	B	V	3/4"	6	0'-10"	S
K1	1/2"	12	2'-10"	B	Y	3/8"	90	2'-10"	B
K2	1/2"	4	4'-2"	B	Z	1/2"	2	25'-1"	S
L1	1/2"	6	2'-8"	B					
L2	1/2"	6	2'-10"	B					
L3	1/2"	6	3'-0"	B					
L4	1/2"	6	3'-2"	B					
L5	1/2"	6	3'-5"	B					

SUMMARY OF QUANTITIES			
	ONE INTERIOR SPAN	ONE END SPAN	
Class "A" Concrete	40.44	42.45	CY.
Reinforcing Steel	10,419	10,403	Lbs.
Pipe Handrail	60	60	L.F.

BREAKDOWN OF CONCRETE QUANTITIES		
	ONE INT. SPAN	ONE END SPAN
Beams, Slab, Brackets	34.96	36.82
Sidewalk	3.96	4.05
Handrail & Posts	1.52	1.58
Totals	40.44	42.45

S. C. STATE HIGHWAY DEPARTMENT
COLUMBIA




30' SPAN 30' R'D'WY 2.5'SW
FOR BRIDGE OVER

CANNONS CREEK

DOCKET NO. 36.241 ROUTE NO. 177
COUNTY NEWBERRY DATE OCT. 1948
C 30-30-2.5 1948



REV.	RWH	B.M.C.	10-48
			For Docket 36.241
QUAN.	60	C.E.S.	10-48
TR.	N.R.T.	R.W.H.	10-48
DR.	B.Y.C.	R.W.H.	7-48
DES.	W.E.C.	R.W.H.	7-48
	B4	C.K.D.	DATE

ROAD DIST. NO.	STATE	COUNTY	DOCKET NO.	ROUTE	SHEET NO.	TOTAL SHEETS
5	S.C.	NEWBERRY	5622	ITT	9	19

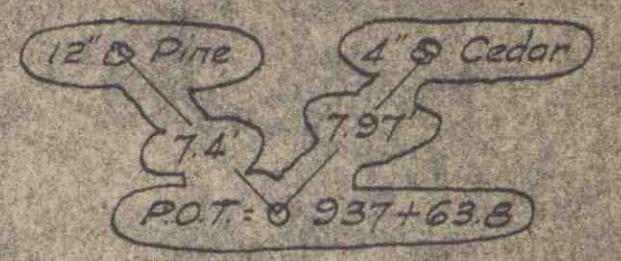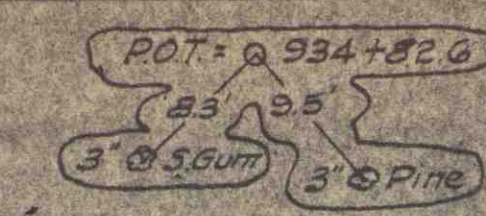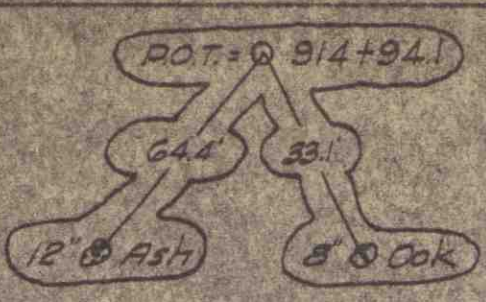

PLAN
SCALE: 1" = 40' HORIZ. 1" = 4' VERT.
NOTES: 1. ALL DISTANCES IN FEET UNLESS OTHERWISE NOTED.
2. ALL ANGLES IN DEGREES UNLESS OTHERWISE NOTED.


PROJECT: BRIDGE AND CHANNEL IMPROVEMENTS
LOCATION: BRIDGE OVER CHANNEL
DRAWN BY: [Name]
CHECKED BY: [Name]
DATE: [Date]

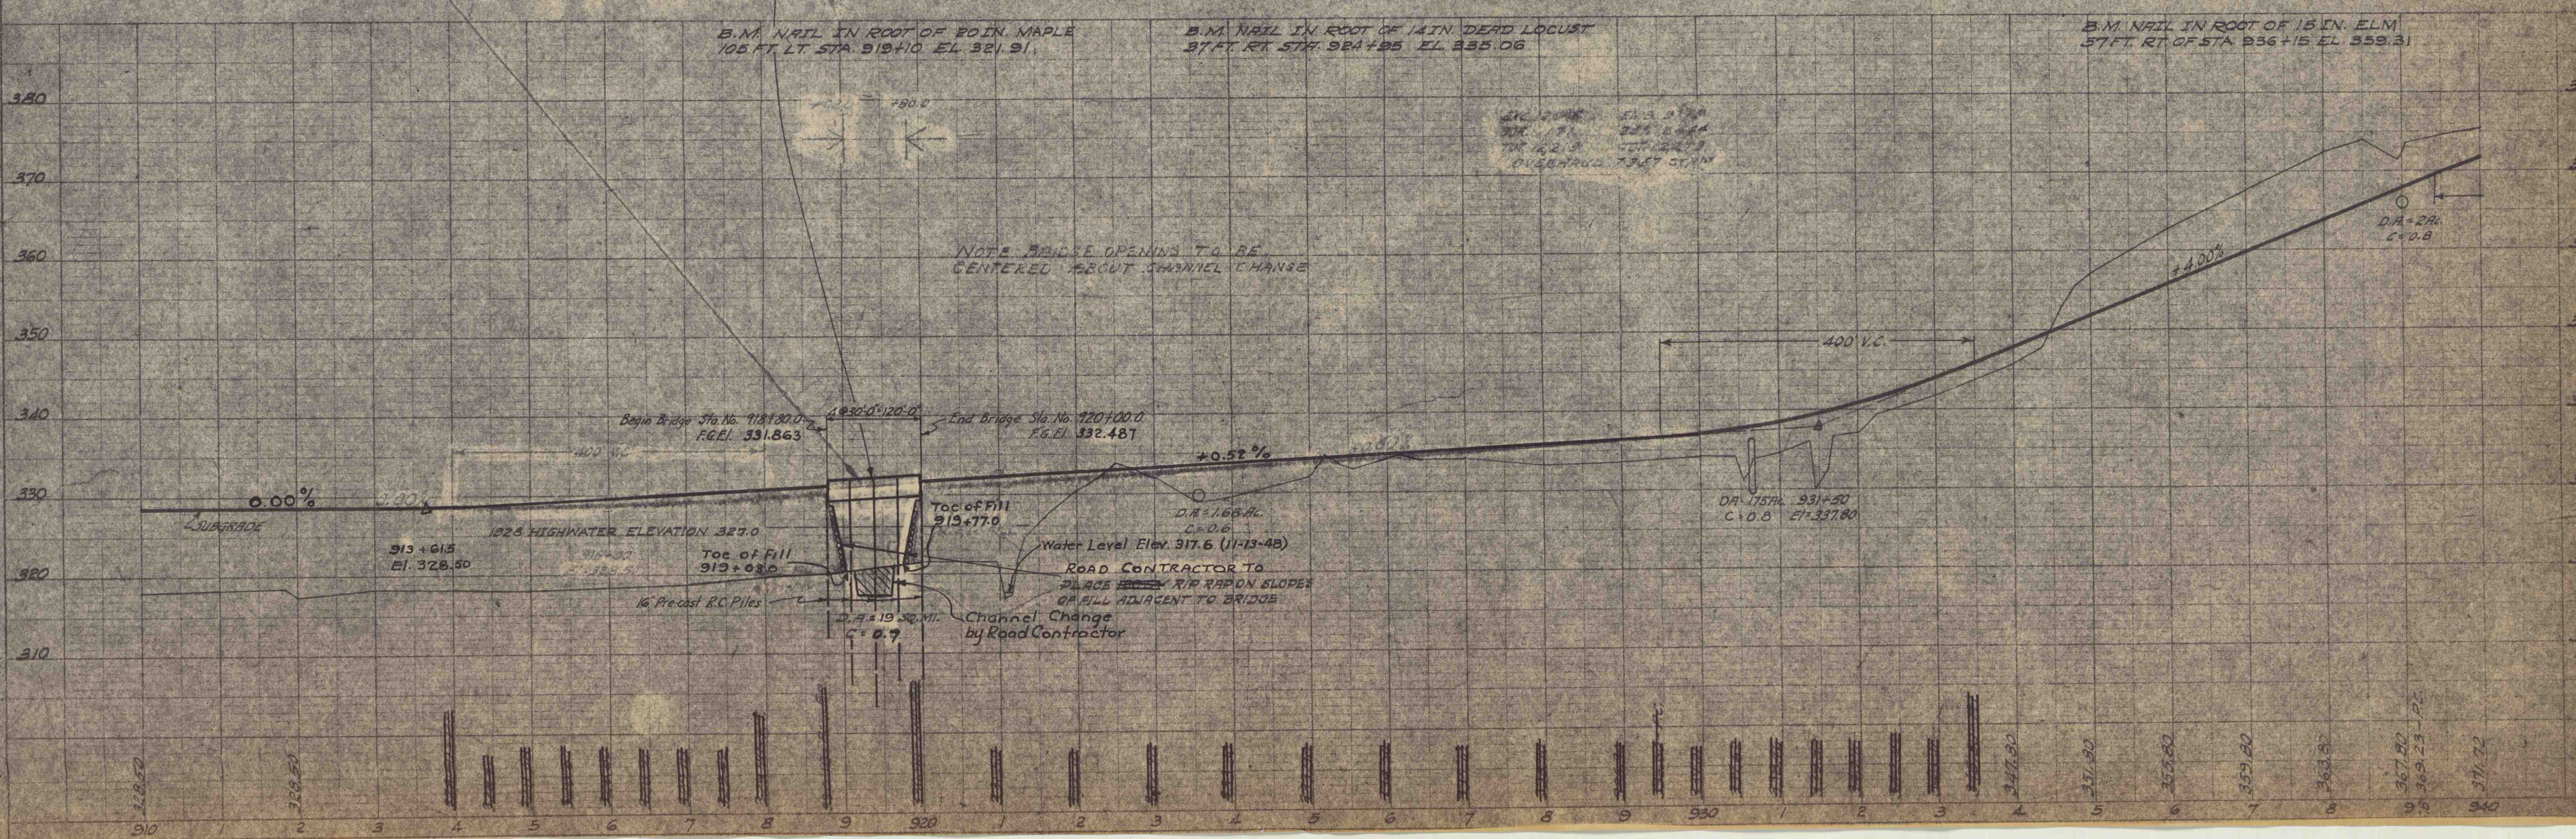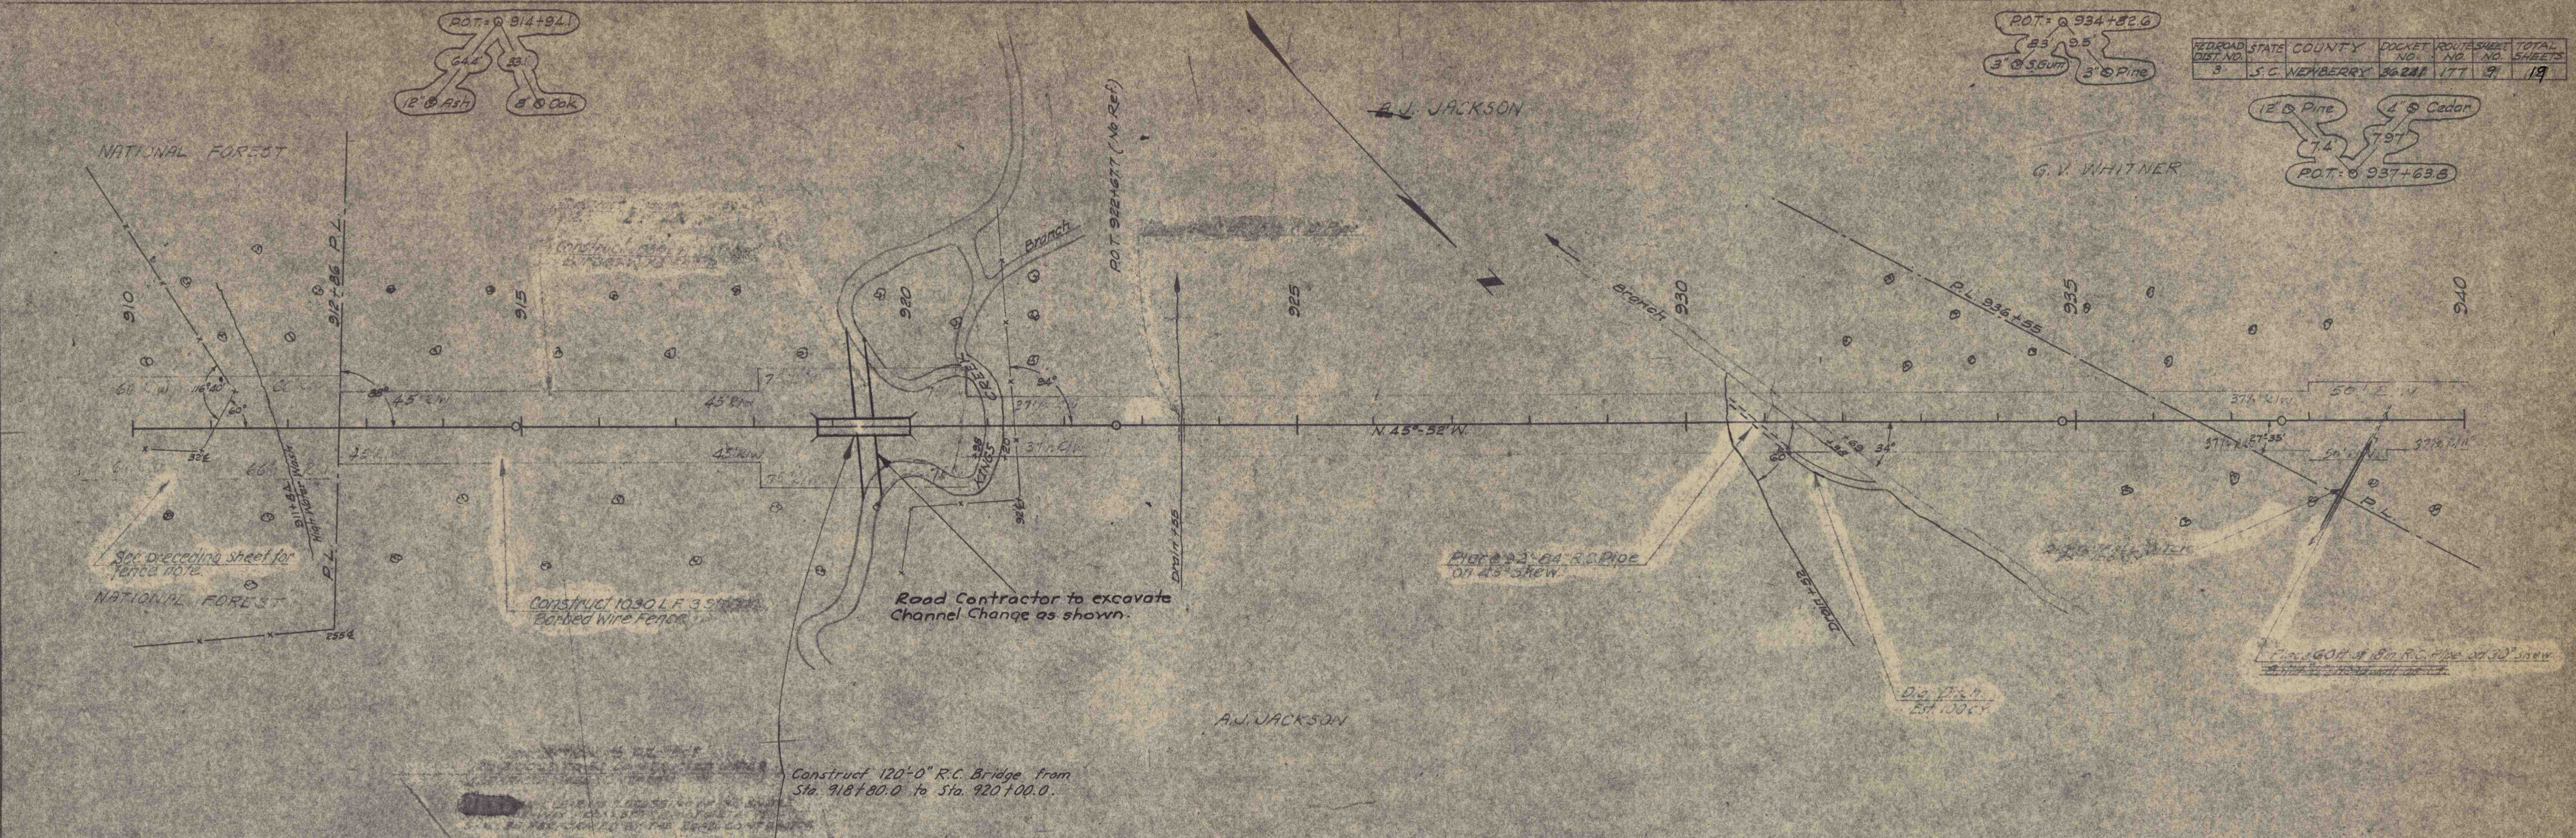


BRIDGE AND CHANNEL IMPROVEMENTS

PLAN
 SURVEY PLOTTED
 ALIGNMENT CHECKED
 RT OF WAY CHECKED

PROFILE
 SURVEY PLOTTED
 CROSS SECTIONS
 B.M. & NOTED
 STRUCTURE NOTATIONS, etc.

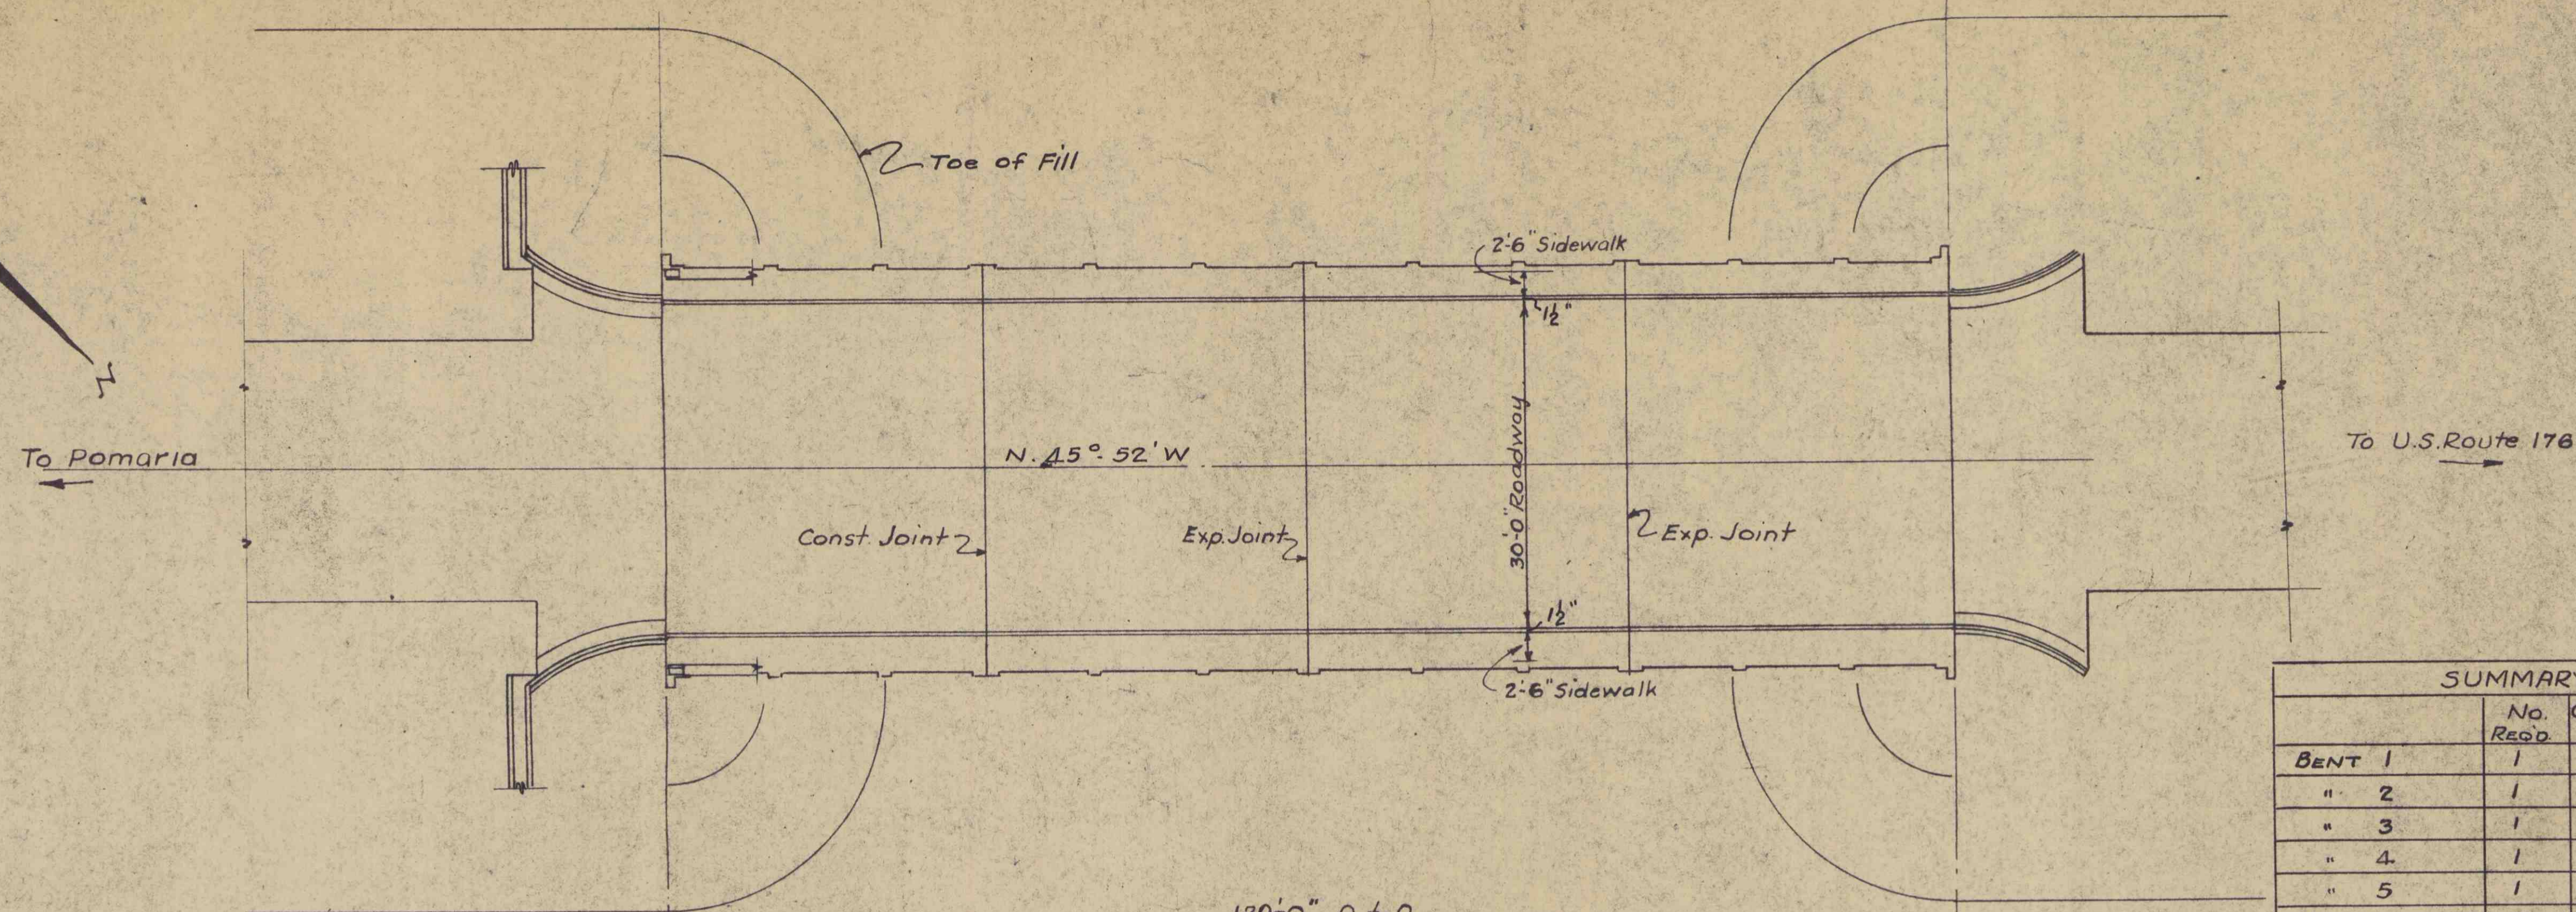

	No.	CEM. CONC. CL. "A"	REINF. STEEL	16" PRECAST CONC. PILING	CONC. TILE SLOPE DRAIN	PIPE HANDRAIL
BENT 1	1	5.45	852	SEE TOTAL	—	—
" 2	1	5.45	852	"	—	—
" 3	1	5.45	852	"	—	—
" 4	1	5.45	830	"	—	—
" 5	1	5.45	852	"	—	—
30 FT. END SPAN	2	84.90	20806	—	SEE TOTAL	120
30 FT. INT. SPAN	2	80.88	20838	—	—	120
FL. CURB & GUTTER	2	2.24	—	—	—	—
TOTAL		195.27 C.Y.	45,882 LBS.	625 L.F.	45 L.F.	240 L.F.

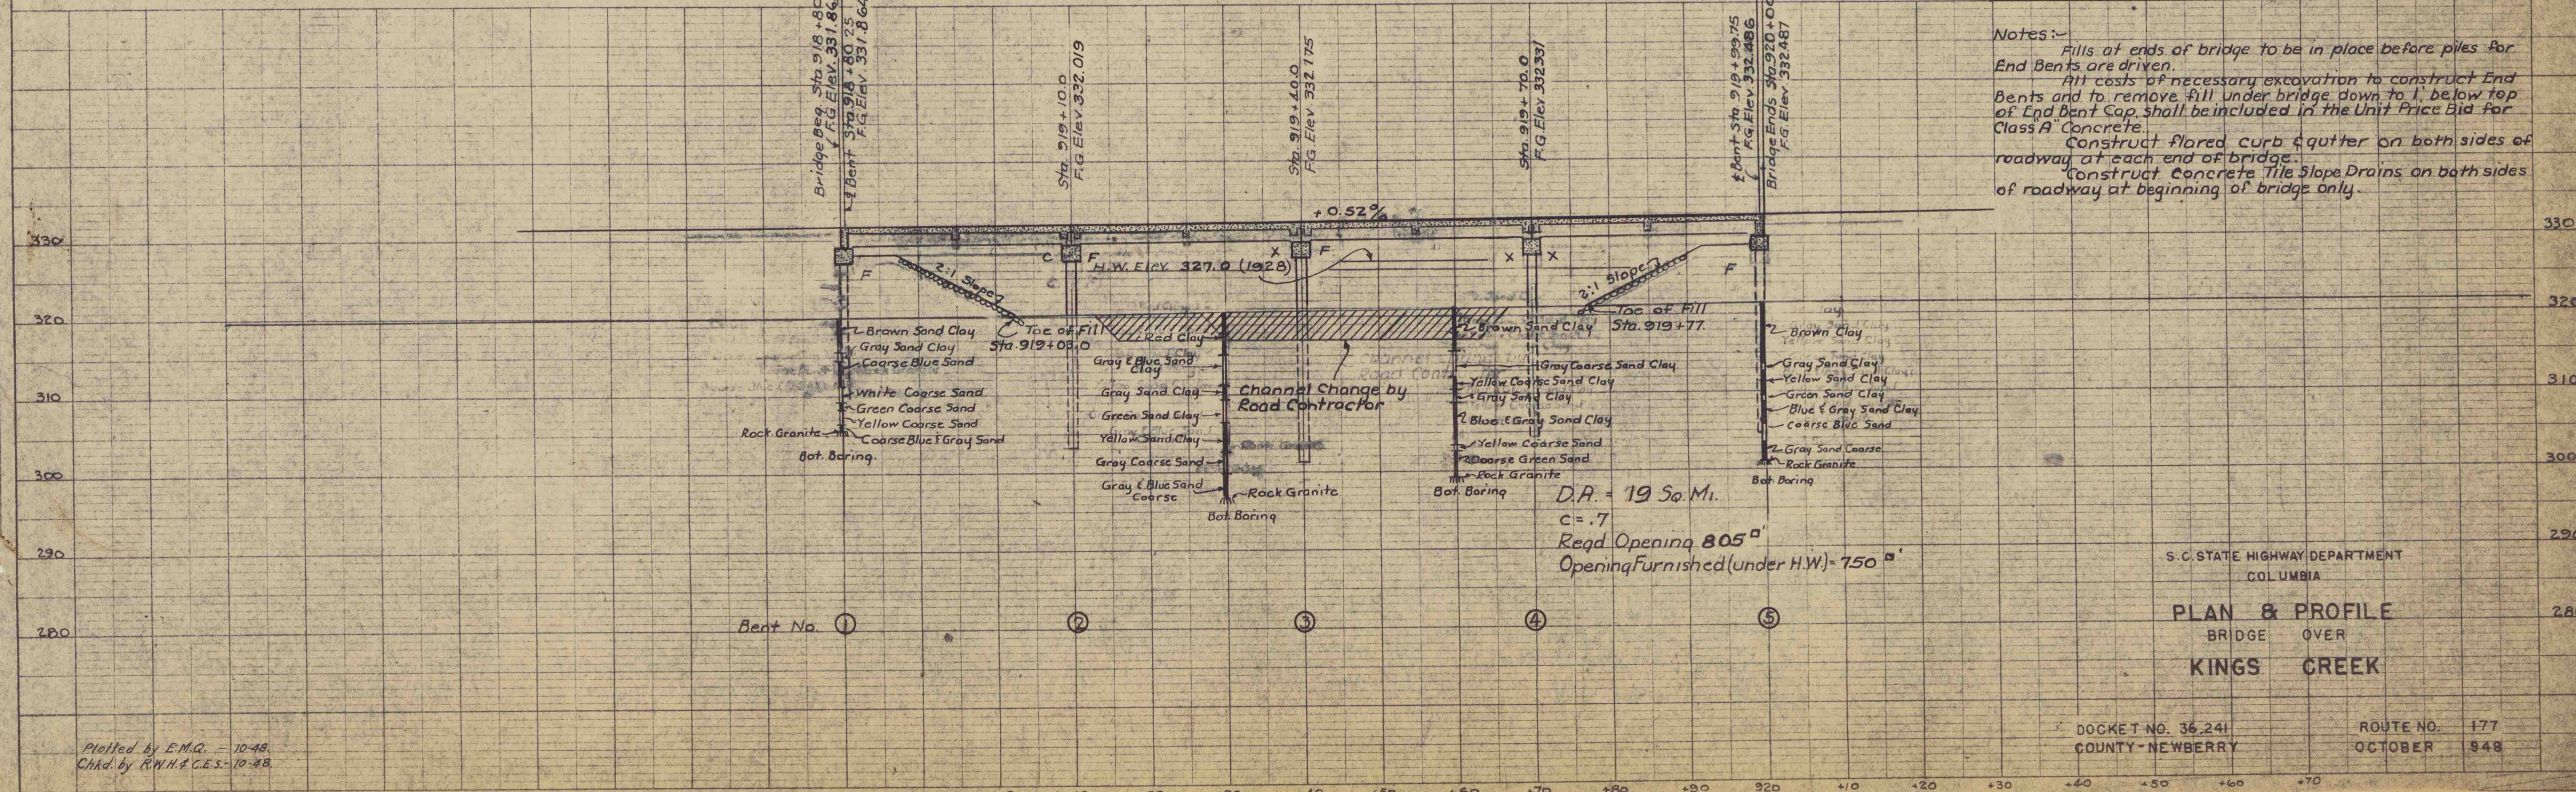


Notes:-
 Fills at ends of bridge to be in place before piles for End Bents are driven.
 All costs of necessary excavation to construct End Bents and to remove fill under bridge down to 1' below top of End Bent Cap shall be included in the Unit Price Bid for Class A Concrete.
 Construct floored curb & gutter on both sides of roadway at each end of bridge.
 Construct Concrete Tile Slope Drains on both sides of roadway at beginning of bridge only.

S. C. STATE HIGHWAY DEPARTMENT
 COLUMBIA
PLAN & PROFILE
 BRIDGE OVER
KINGS CREEK

Plotted by E.M.G. - 10-48
 Chkd. by R.W.H. & C.E.S. - 10-48

DOCKET NO. 36,241
 COUNTY - NEWBERRY
 ROUTE NO. 177
 OCTOBER 1948

FED. ROAD DIV. No.	STATE	COUNTY	DOCKET No.	ROUTE No.	SHEET No.	TOTAL SHEETS
3	S.C.	NEWBERRY	36.241	177	11	19

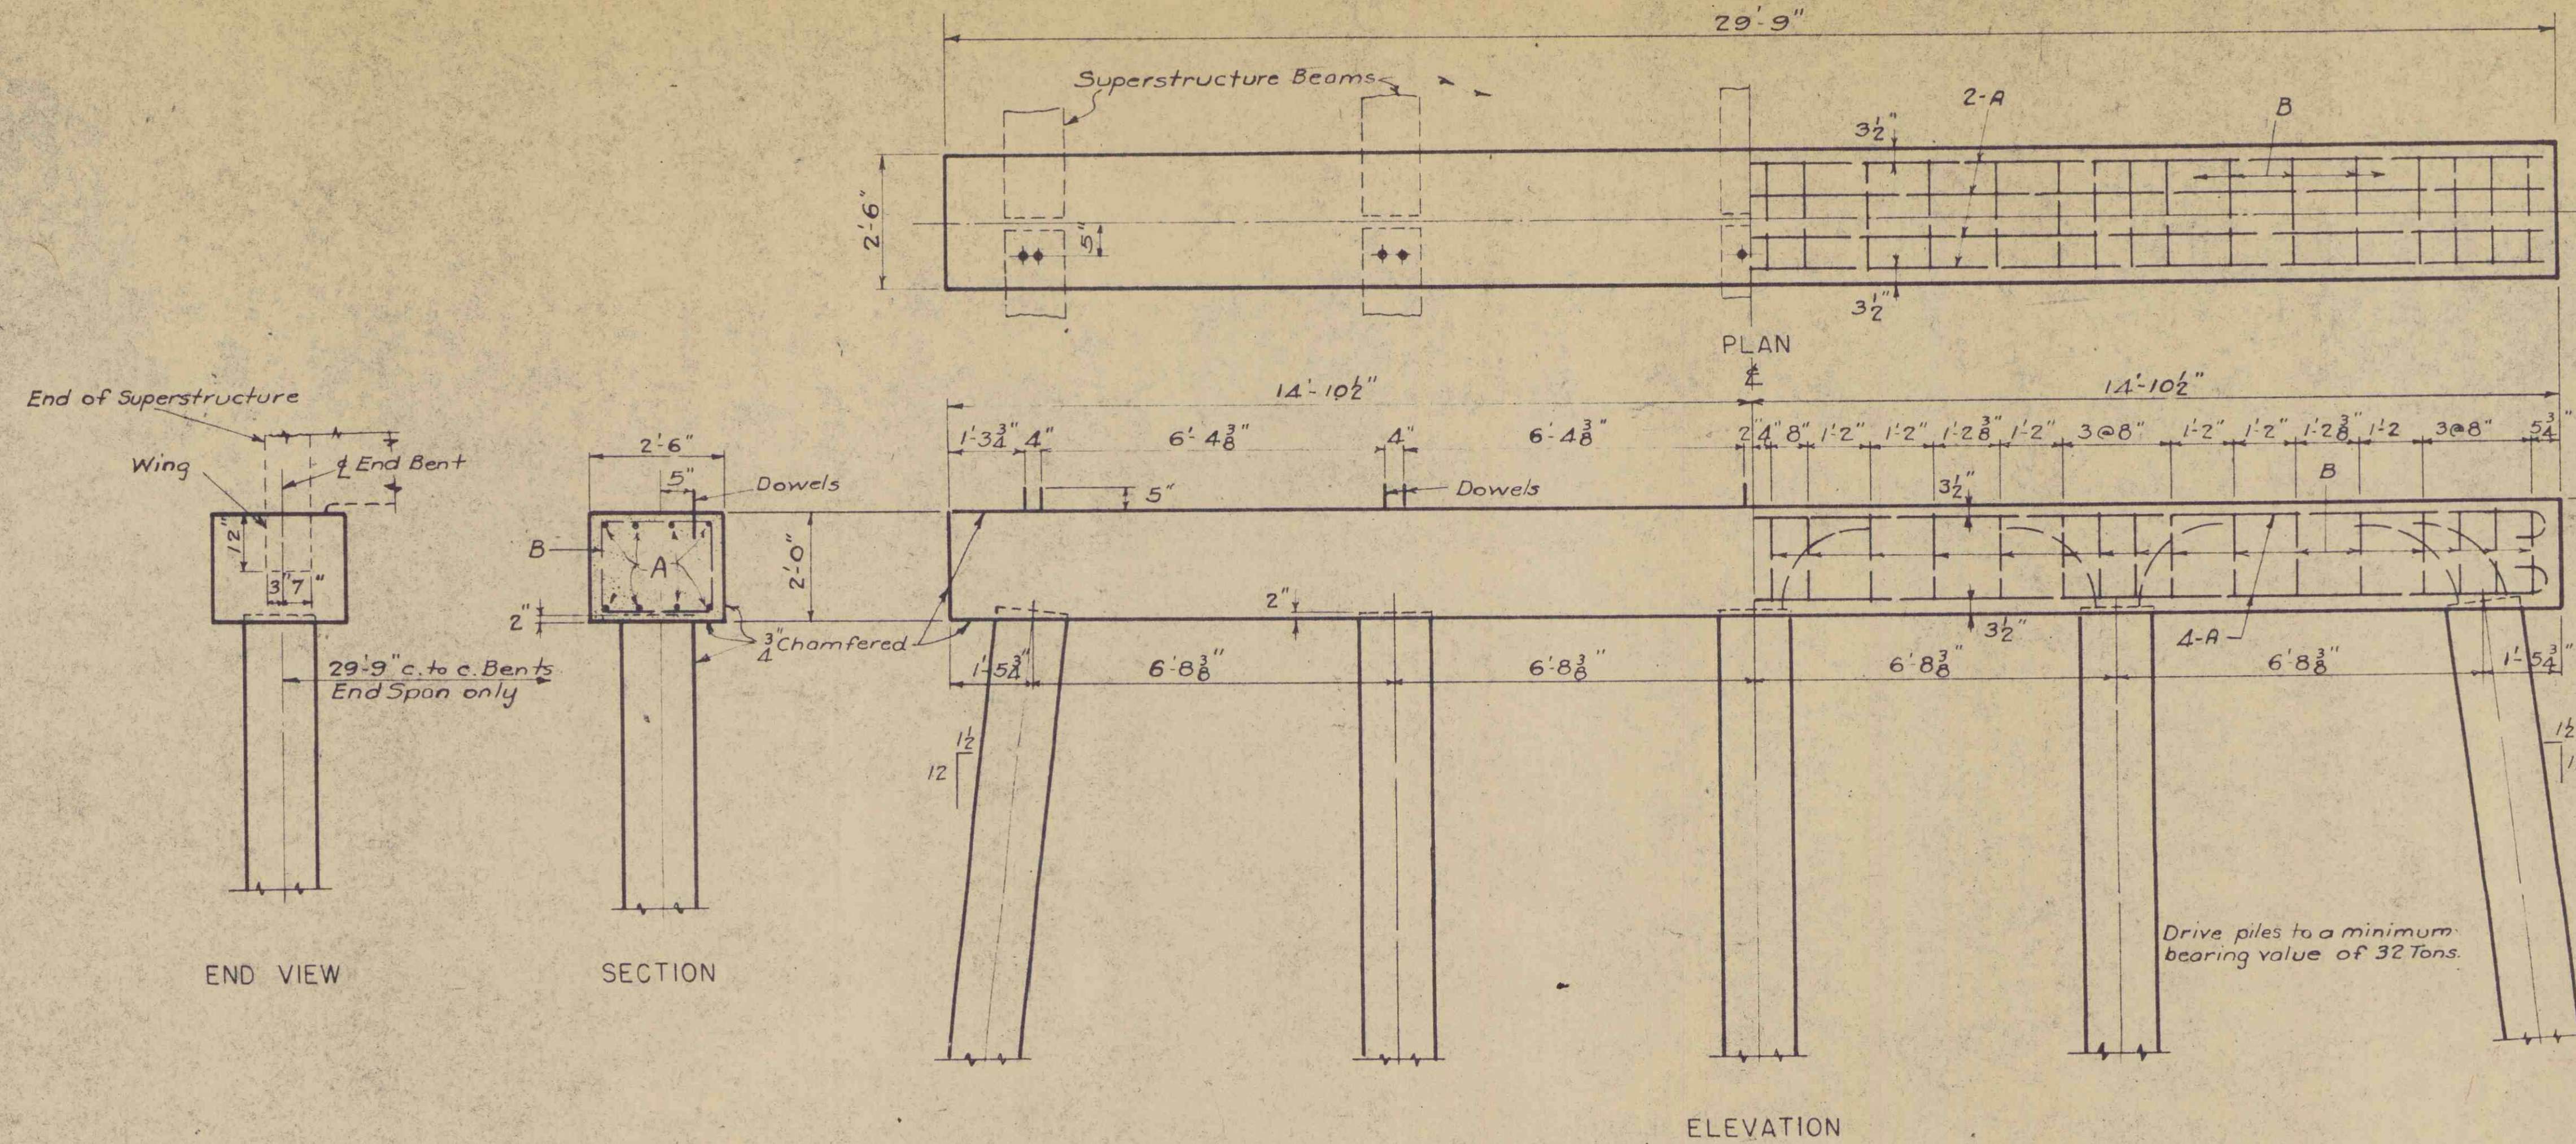

Bent 1 El. 329.052
 Bent 2 El. 329.206
 Bent 3 El. 329.362
 Bent 4 El. 329.518
 Bent 5 El. 329.673

STEEL SCHEDULE				
MARK	No.	SIZE	LENGTH	BENDING DETAILS
A	8	1"Ø	31'-3"	
B	32	2"Ø	7'-8"	
* Dowels	10	1"Ø	0'-10"	
CONC. CL. A			5.45 CY	
REIN. STEEL			*852 LBS	


* Deduct 10 Dowels (22 Lbs) for Bent No. 4.

12, 24, 2 and smaller bars add 6" per hook.
 2, 3, 4, 5, 6, 7, 8 and 9 bars add 8" per hook.
 10, 11, 12, 13, 14, 15, 16, 17, 18, 19, 20, 21, 22, 23, 25, 26, 27, 28, 29, 30, 31, 32 and larger bars add 12" per hook.

HOOK DETAILS

Notes—
 All concrete to be Class "A"
 All exposed edges to be chamfered
 1/4" unless otherwise noted.

QUANTITIES FOR 40'-0" PILE
 Concrete - 2.560 CY. Reinforcing Steel - 690 Lbs.
 For quantities for lengths greater or less than 40'-0" add or subtract 0.066 CY of concrete and 17.18 Lbs of Reinforcing Steel.

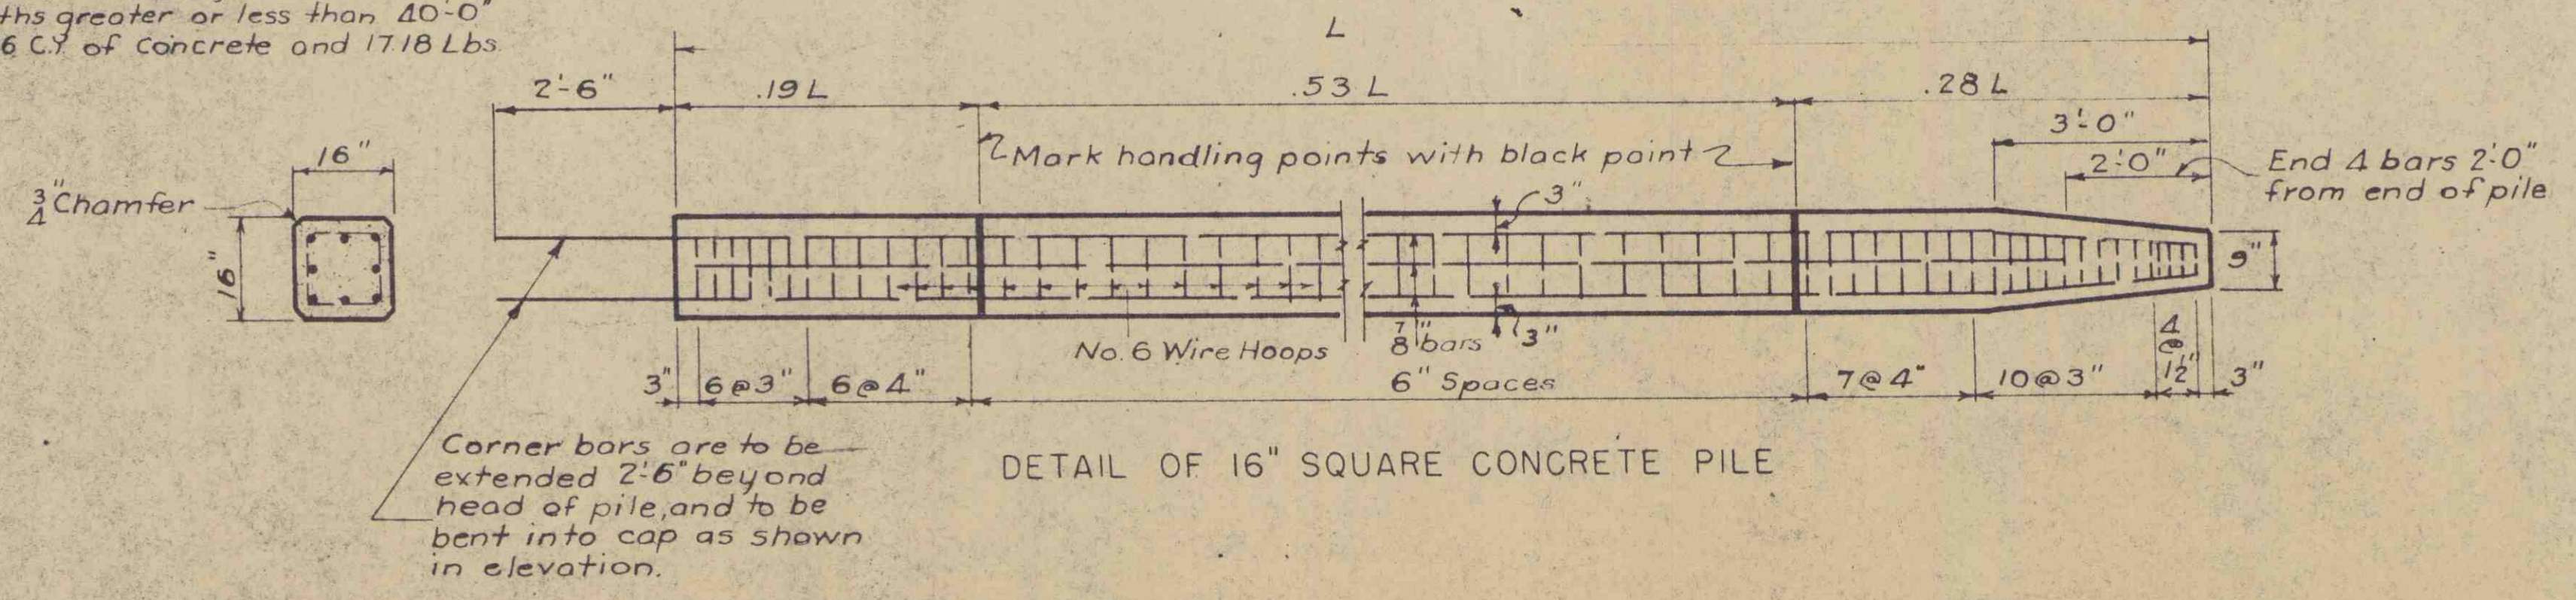

Corner bars are to be extended 2'-6" beyond head of pile, and to be bent into cap as shown in elevation.

Rev.	R.W.H. B.M.C. 10-48
	For Dock 36.241.
Quan.	EMG AMC 10-48
Traced	EMG AMC 10-48
Dwn.	EMG AMC 10-48
Des.	WEC AMC 10-48
By	Ch'd. Date

S. C. STATE HIGHWAY DEPARTMENT
 COLUMBIA

**BENT FOR 30' SPAN
 FOR BRIDGE OVER
 KINGS CREEK**

DOCKET NO. 36.241 ROUTE NO. 177
 COUNTY NEWBERRY DATE OCT. 1948

16" R.C. PILE BENT C30-30-2.5 1948

CROSS SECTION


SCALE 1 INCH = 5 FEET

FED. ROAD DIST. NO.	STATE	COUNTY	FED. AID PROJ. NO.	ROUTE NO.	SHEET NO.	TOTAL SHEETS
14	S. C.	WEBBER	2562(3)	177	13	19

20 10 0 10 20 25 20 10 0 10 20 25 20 10 0

B-1 - P-51-55

PROFILE CANNONS CREEK BRIDGE

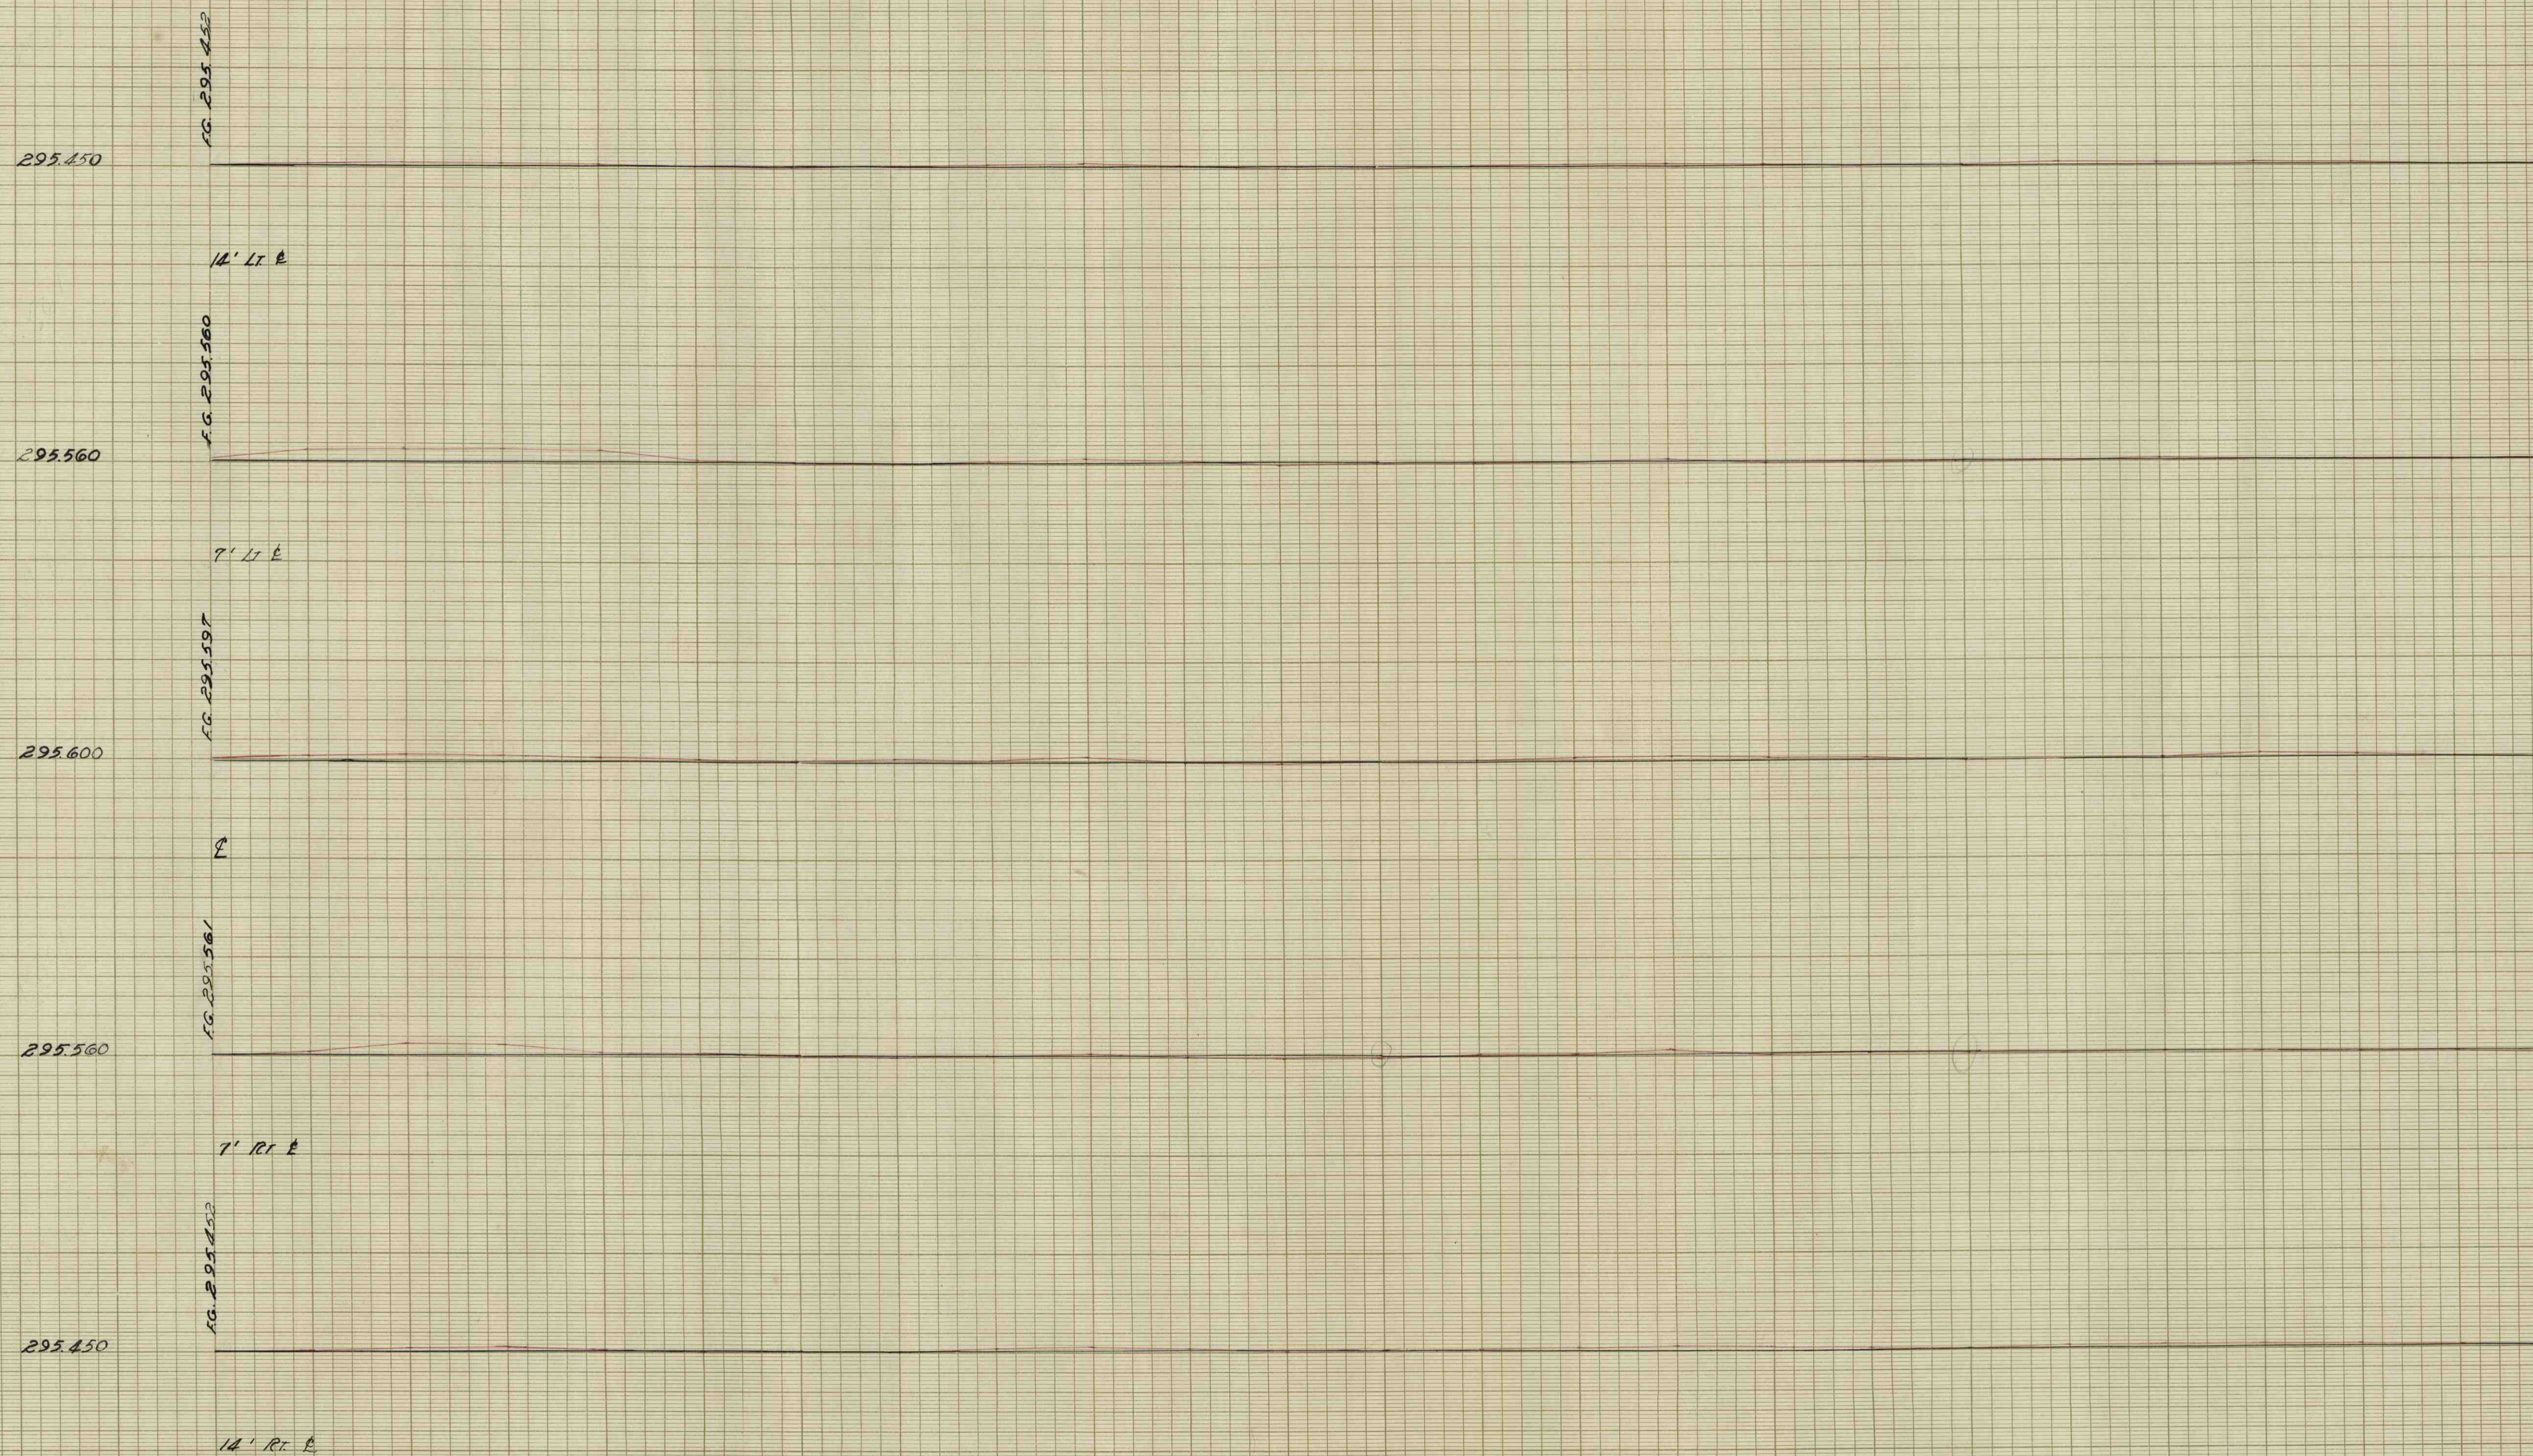

1510

Ground Surface Platted by JHM
 " " Checked by _____
 Template Sections Platted by _____
 " " Checked by _____
 Areas by _____
 " " Checked by _____
 Template Sections Revised by _____
 " " Checked by _____
 Final Areas by _____
 " " Checked by _____
 Quantities Transferred and Inked by _____

SCALE
 1 INCH = 5 FEET HORIZONTAL
 1 INCH = 0.125 FEET VERTICAL

20 10 0 10 20 25 20 10 0 10 20 25 20 10 0

CROSS SECTION

SCALE 1 INCH=5 FEET

FED. ROAD DIST. NO.	STATE	COUNTY	FED. AID PROJ. NO.	ROUTE NO.	SHEET NO.	TOTAL SHEETS
14	S. C.	NEWBERRY	8562(3)	17A	14	19

20 10 0 10 20 25 20 10 0 10 20 25 20 10 0

B-1 P. 51-55

PROFILE CANNONS CREEK BRIDGE

295.450

14' LI. E

295.560

7' LI. E

295.600

E

295.560

7' RI. E

295.450

14' RI. E

355430

355460

355490

20 10 0 10 20 25 20 10 0 10 20 25 20 10 0


Ground Surface Platted by J.M.H.
" " Checked by _____
Template Sections Platted by _____
" " Checked by _____
Areas by _____
" " Checked by _____
Template Sections Revised by _____
" " Checked by _____
Final Areas by _____
" " Checked by _____
Quantities Transferred and Inked by _____

CROSS SECTION
SCALE 1 INCH=5 FEET

FED. ROAD DIST. NO.	STATE	COUNTY	FED. AID PROJ. NO.	ROUTE NO.	SHEET NO.	TOTAL SHEETS
14	S. C.	Newberry	2562(S)	177	15	19

B-2-P-25-29

PROFILE KINGS CREEK BRIDGE

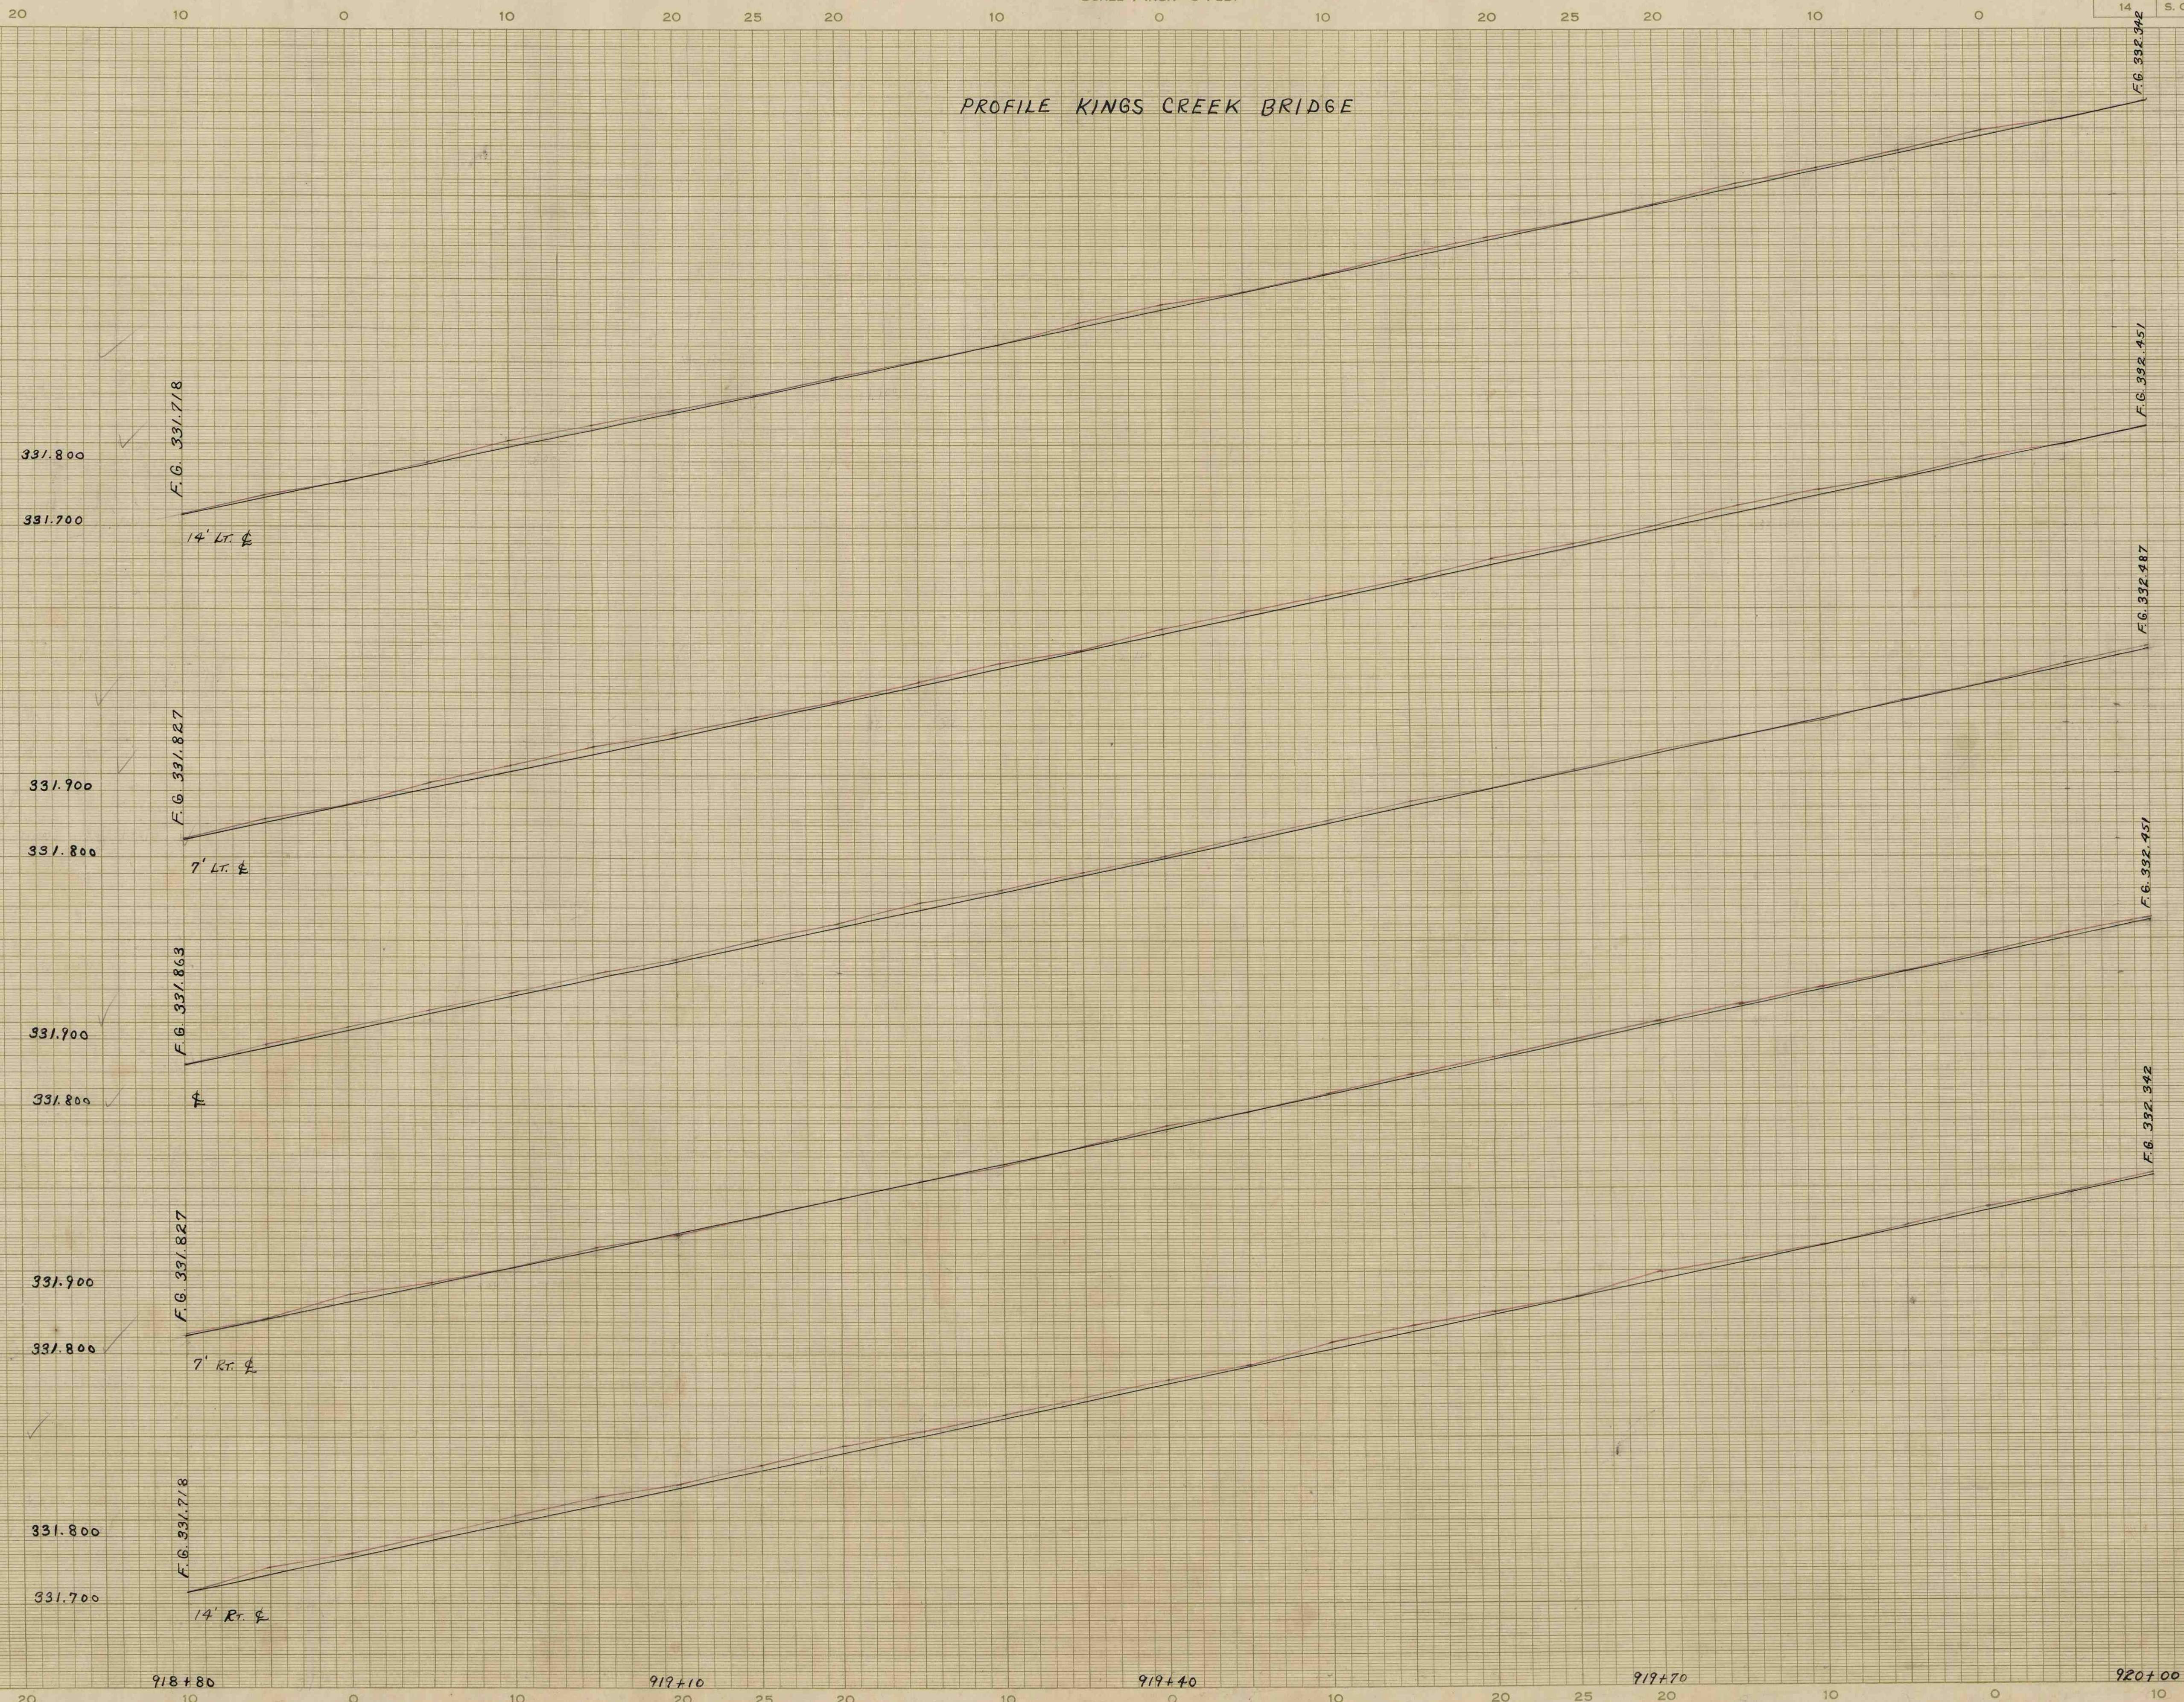

Ground Surface Platted by	Checked by
Template Sections Platted by	Checked by
Areas by	Checked by
Template Sections Revised by	Checked by
Final Areas by	Checked by
Quantities Transferred and Inked by	


SCALE
1" = 5' HORIZONTAL
1" = 0.125' VERTICAL

CROSS SECTION

SCALE 1 INCH=5 FEET

FED. ROAD DIST. NO.	STATE	COUNTY	FED. AID PROJ. NO.	ROUTE NO.	SHEET NO.	TOTAL SHEETS
14	S. C.	Newberry	2562(5)	177	16	19

CANNONS CREEK

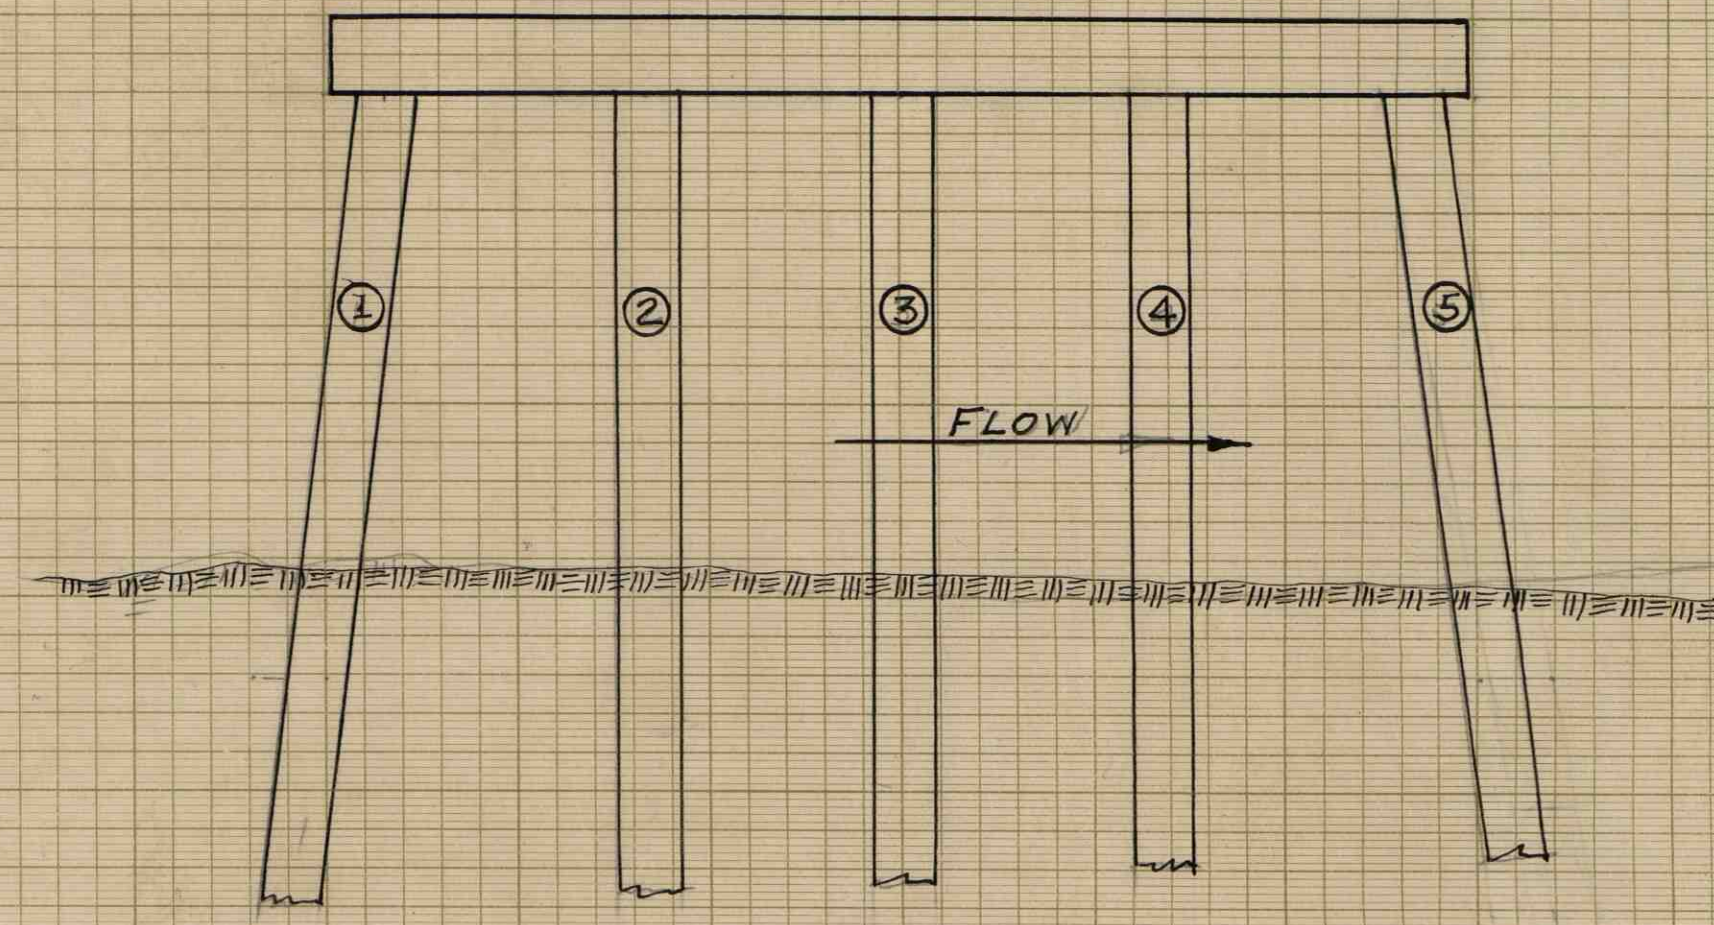


ELEVATION

Note: Bents Numbered Same as on Plan Sheet No G

BENT No	PILING	ELEV CUT OFF	ELEV. GROUND	LENGTH ABOVE GR.	LENGTH IN PLACE	PENETRATION
1	1	290.951			25.0	
	2	"			25.3	
	3	"			25.0	
	4	"			"	
	5	"			"	
2	1	"			27.2	
	2	"			26.9	
	3	"			27.9	
	4	"			28.4	
	5	"			25.9	
3	1	"			29.3	
	2	"			31.0	
	3	"			"	
	4	"			29.9	
	5	"			31.0	
4	1	"			31.0	
	2	"			"	
	3	"			"	
	4	"			"	
	5	"			31.0	
5	1	"			31.9	
	2	"			32.0	
	3	"			33.5	
	4	"			34.5	
	5	"			31.0	
6	1	"			36.0	
	2	"			36.5	
	3	"			36.9	
	4	"			36.5	
	5	"			27.2	
7	1	"			26.0	
	2	"			26.1	
	3	"			25.6	
	4	"			"	
	5	"			28.2	

KINGS CREEK

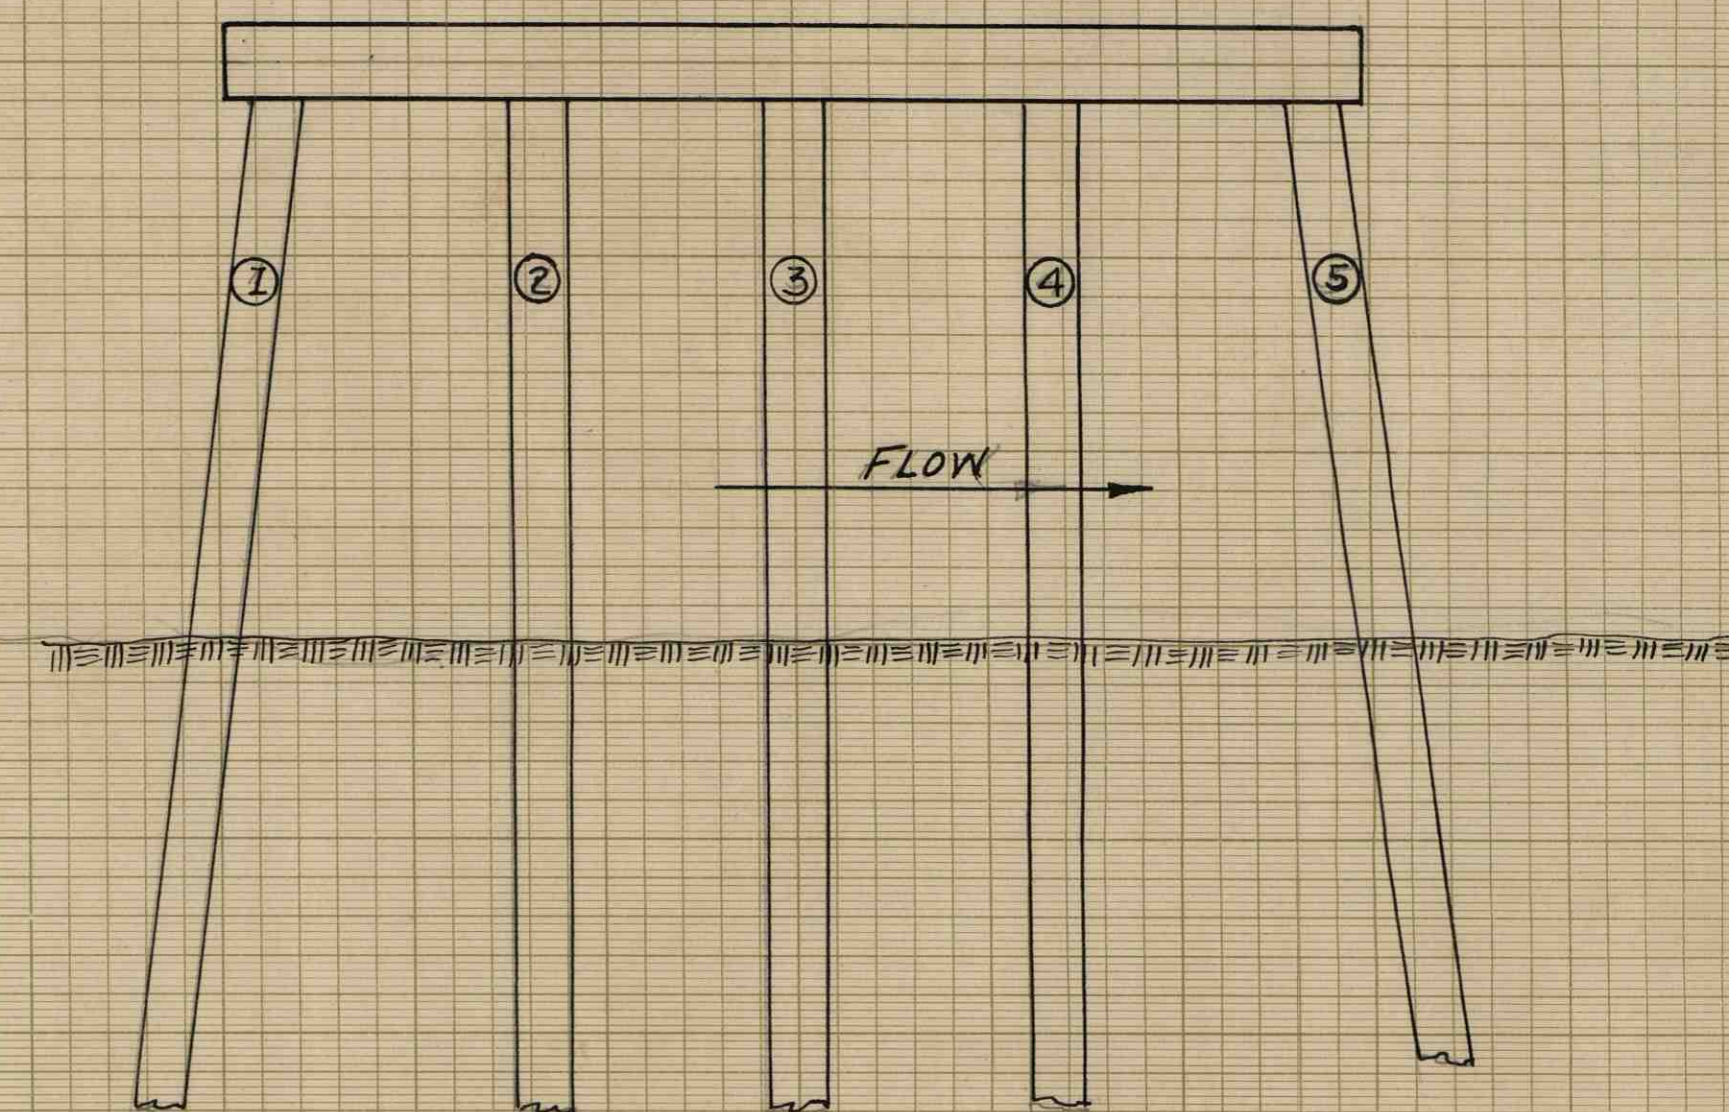

ELEVATION

Note: Bents Numbered Same as on plan sheet No 10

BENT No	PILING	ELEV. CUT OFF	ELEV. GROUND	LENGTH ABOVE GR.	LENGTH IN PLACE	PENETRATION
1	1	327.219	326.8	0.4	22.00	21.6
	2	"	"	"	"	"
	3	"	"	"	"	"
	4	"	"	"	"	"
	5	"	"	"	"	"
2	1	327.373	320.4	7.0	27.00	20.0
	2	"	"	"	"	"
	3	"	"	"	"	"
	4	"	"	"	"	"
	5	"	"	"	"	"
3	1	327.529	316.5	11.0	27.00	16.0
	2	"	"	"	"	"
	3	"	"	"	"	"
	4	"	"	"	"	"
	5	"	"	"	"	"
4	1	327.685	321.2	6.5	27.00	20.5
	2	"	"	"	"	"
	3	"	"	"	"	"
	4	"	"	"	"	"
	5	"	"	"	"	"
5	1	327.840	326.1	1.7	22.00	20.3
	2	"	"	"	"	"
	3	"	"	"	24.45	22.8
	4	"	"	"	24.47	22.8
	5	"	"	"	22.00	20.3

Ground Surface Platted by _____
 " " Checked by _____
 Template Sections Platted by _____
 " " Checked by _____
 Areas by _____
 " " Checked by _____
 Template Sections Revised by _____
 " " Checked by _____
 Final Areas by _____
 " " Checked by _____
 Quantities Transferred and Inked by _____

POURING RECORD ON DOCKET NO. 36.241

CANNONS CREEK & KINGS CREEK BRIDGE

Dist. Road Div. No.	State	County	Docket No.	Route No.	Sheet No.	Total Sheets
3	SC	NEWBERRY	36.241	177	17	19

DATE	PART OF STRUCTURE	MATERIAL RECORD					APPROX QUANT C.Y.	THERO BAGS REQ'D	TOTAL BAGS USED	CEMENT NOT TO BE ADJUSTED			NET CEMENT TO BE ADJUSTED	DATE	PART OF STRUCTURE	MATERIAL RECORD					APPROX QUANT C.Y.	THERO BAGS REQ'D	TOTAL BAGS USED	CEMENT NOT TO BE ADJUSTED			NET CEMENT TO BE ADJUSTED	DATE	PART OF STRUCTURE	MATERIAL RECORD					APPROX QUANT C.Y.	THERO BAGS REQ'D	TOTAL BAGS USED	CEMENT NOT TO BE ADJUSTED			NET CEMENT TO BE ADJUSTED
		CEMENT		COARSE AGGREGATE		SAND				PAR. 716 5 (A) WASTE	PAR. 716 5 (C) BEYOND PAY LINES	PAR. 716 5 (C) OVER OR UNDER THEO				CEMENT		COARSE AGGREGATE		SAND				PAR. 716 5 (A) WASTE	PAR. 716 5 (C) BEYOND PAY LINES	PAR. 716 5 (C) OVER OR UNDER THEO				CEMENT		COARSE AGGREGATE		SAND				PAR. 716 5 (A) WASTE	PAR. 716 5 (C) BEYOND PAY LINES	PAR. 716 5 (C) OVER OR UNDER THEO	
		TYPE	BRAND	TYPE	SOURCE	SOURCE										TYPE	BRAND	TYPE	SOURCE	SOURCE										TYPE	BRAND	TYPE	SOURCE	SOURCE							
CANNONS CREEK													PILING - CANNONS CREEK & KINGS CREEK													KINGS CREEK															
10-19	CAPS - 1 & 3	II	VOLUNTEER	#4	BLAIR	DIXIANA	10.90	68	69	+		1 68	2-14	PILING - 5-25	II	VOLUNTEER	#4	BLAIR	DIXIANA	7.85	49	51	1		50 1	7-29	CAPS 5 & 4	II	VOLUNTEER	#4	BLAIR	DIXIANA	10.90	68	75	2		78 5			
10-20	" 2 & 4	"	"	"	"	"	10.90	68	75	2		5 73	2-15	5-25	"	"	"	"	"	7.85	49	52	1		51 2	8-10	" 3 & 2	"	"	"	"	10.90	68	73	1		72 4				
10-28	SLAB #1	"	"	"	"	"	36.82	230	247	+		17 246	2-17	5-31	"	"	"	"	"	9.83	62	63	+		62 1	7-16	SLAB #4	"	"	"	"	36.82	230	242	1		241 11				
11-3	" #2	"	"	"	"	"	34.96	219	231	+		12 230	2-18	5-25	"	"	"	"	"	7.85	49	52	1		51 2	8-25	" #3	"	"	"	"	34.96	219	220	+		219 1				
11-9	" #3	"	"	"	"	"	34.96	219	234	+		15 233	2-21	5-31	"	"	"	"	"	9.83	62	62	+		61	9-1	" #2	"	"	"	"	34.96	219	220	+		219 1				
11-10	CAP #5	"	"	"	"	"	5.45	34	34	+		33	2-22	5-31	"	"	"	"	"	9.83	62	64	1		63 1	9-2	CAP #1	"	"	"	"	5.45	34	35	+		34 1				
11-17	SLAB #4	"	"	"	"	"	34.96	219	235	3		13 232	2-23	5-31	"	"	"	"	"	9.83	62	63	+		62 1	9-12	SLAB #1	"	"	"	"	36.82	230	237	1		236 6				
11-21	CAP #6-7	"	"	"	"	"	10.90	68	72	+		4 71	2-25	5-22	"	"	"	"	"	6.86	43	44	+		43 1	9-20	SIDEWALK #4	"	"	"	"	4.05	26	27	+		26 1				
11-25	SLAB #5	"	"	"	"	"	34.96	219	230	2		9 226	2-28	5-27	"	"	"	"	"	8.51	53	55	1		54 1	9-21	" #3	"	"	"	"	3.96	25	26	+		25 1				
11-29	SIDEWALK #1	"	"	"	"	"	4.05	26	26	+		25	3-2	5-22	"	"	"	"	"	6.86	43	44	+		43 1	9-23	" #2	"	"	"	"	3.96	25	25	+		24				
12-2	" #2	"	"	"	"	"	3.96	25	26	1		25	3-3	5-27	"	"	"	"	"	8.51	53	55	1		54 1	9-28	" #1	"	"	"	"	4.05	26	26	+		25				
12-5	SLAB #6	"	"	"	"	"	36.82	230	244	+		14 243	3-7	5-27	"	"	"	"	"	8.51	53	55	1		54 1	10-4	HANDRAIL Lt. SIDE	"	"	"	"	3.10	20	20	+		19				
12-8	SIDEWALK #3	"	"	"	"	"	3.96	25	26	1		25	11-10	PILING - 8 1/2	"	"	"	"	"																						
12-16	RAIL 1-2-3 Et.	"	"	"	"	"	2.31	15	16	+		15	11-10	" 8 1/2	"	"	"	"	"																						
12-16	SIDEWALK #4	"	"	"	"	"	3.96	25	26	+		26	11-10	" 8 1/2	"	"	"	"	"																						
12-22	WALK #5	"	"	"	"	"	3.96	25	27	1		26																													
12-29	RAIL 1-2-3 Lt.	"	"	"	"	"	2.31	15	15	+		14																													
	" WALK SLAB #6	"	"	"	"	"	4.05	26	26	+		26																													
1-3	RAIL 4-5-6 Lt.	"	"	"	"	"	2.31	15	15	+		14																													
1-6	RAIL 4-5-6 Et.	"	"	"	"	"	2.31	15	15	+		13																													
1-6	Curb & Gutter S End	"	"	"	"	"	1.12	7	7	0		7																													
1-10	" " N End	"	"	"	"	"	1.12	7	7	2		5																													
CARRIED FORWARD													CARRIED FORWARD													CARRIED FORWARD															
287.05													660 12													195.27															
93 93													13													32 32															
1876													698													1246															
GRAND TOTAL													GRAND TOTAL													GRAND TOTAL															
482.32													482.32													482.32															
3824													3824													3824															
50													50													50															
54													54													54															
3770													3770													3770															

[Handwritten signature]

PILE RECORD ON DOCKET NO. 36.241

FED ROAD DIST. NO.	STATE	COUNTY	DOCKET NO.	ROUTE NO.	SHEET NO.	TOTAL SHEETS
14	S.C.	Newberry	36.241	177	18	19

WEIGHT OF HAMMER 5000 LBS FALL 3' TYPE SINGLE ACTING STEAM																																					
BENT NO.	FOOTING	PILE NO.	DATE DRIVEN	DIAMETER BUTT	DIAMETER TIP	PENETRATION	PEN. PER BLOW	BEARING	ELEVATION PILE TIP	ELEVATION CUT-OFF	LENGTH IN PLACE	ORIGINAL LENGTH	LENGTH CUT-OFF	PAY LENGTH	C.O. AT 0.40 OF UNIT PRICE	C.O. AT 0.25 OF UNIT PRICE	BENT NO.	FOOTING	PILE NO.	DATE DRIVEN	DIAMETER BUTT	DIAMETER TIP	PENETRATION	PEN. PER BLOW	BEARING	ELEVATION PILE TIP	ELEVATION CUT-OFF	LENGTH IN PLACE	ORIGINAL LENGTH	LENGTH CUT-OFF	PAY LENGTH	C.O. AT 0.40 OF UNIT PRICE	C.O. AT 0.25 OF UNIT PRICE				
CANNONS CREEK <small>B-1-P-5-12</small>														KINGS CREEK <small>B-2-P-6</small>																							
1		1	Sept 29			1/8	46.0	T	290.951	290.951	25.0	25.0		25.0			1		1	July 20			21.6	5/32	42.1	327.219	327.219	22.00	22.00			22.00					
		2	"			1/4	33.3		290.651	"	25.3	"		25.3					2	"			"	1/4	33.3	"	"	"	"	"	"	"	"	"			
		3	"			3/16	38.7		290.951	"	25.0	"		25.0					3	July 21			"	3/16	38.7	"	"	"	"	"	"	"	"	"			
		4	"			1/8	46.0		"	"	25.0	"		25.0					4	"			"	3/16	38.7	"	"	"	"	"	"	"	"	"			
		5	"			1/8	46.0		"	"	25.0	"		25.0					5	"			"	3/16	38.7	"	"	"	"	"	"	"	"	"			
2		1	Oct 3			1/8	46.0		288.751	"	27.2	25.0		27.2					1	July 18			20.0	5/32	42.1	327.373	327.373	27.00	27.00			27.00					
		2	"			1/8	46.0		289.051	"	26.9	"		26.9					2	"			"	3/16	38.7	"	"	"	"	"	"	"	"	"	"		
		3	"			5/32	42.1		288.051	"	27.9	"		27.9					3	July 19			"	5/32	42.1	"	"	"	"	"	"	"	"	"	"	"	
		4	"			5/32	42.1		287.551	"	28.4	"		28.4					4	"			"	5/32	42.1	"	"	"	"	"	"	"	"	"	"	"	
		5	"			3/16	38.7		290.051	"	25.9	"		25.9					5	"			"	5/32	42.1	"	"	"	"	"	"	"	"	"	"	"	
3		1	Oct 6			0	75.4		292.651	"	29.3	31.0	1.7	31.0					1	July 14			16.0	5/32	42.1	327.529	327.529	27.00	27.00			27.00					
		2	"			1/32	64.8		290.951	"	31.0	"		"					2	"			"	3/32	51.0	"	"	"	"	"	"	"	"	"	"		
		3	"			1/16	57.1		290.951	"	31.0	"		"					3	"			"	5/32	42.1	"	"	"	"	"	"	"	"	"	"	"	
		4	"			0	75.4		292.051	"	29.9	"	1.1	"					4	"			"	5/32	42.1	"	"	"	"	"	"	"	"	"	"	"	
		5	"			1/10	50.0		290.951	"	31.0	"		"					5	"			"	3/32	51.0	"	"	"	"	"	"	"	"	"	"	"	
4		1	Oct 7			1/8	37.5		290.951	"	31.0	31.0		31.0					1	July 12			20.5	1/4	33.3	327.685	327.685	27.00	27.00			27.00					
		2	"			1/8	40.9		"	"	"	"		"					2	"			"	3/32	51.0	"	"	"	"	"	"	"	"	"	"	"	
		3	"			1/8	40.9		"	"	"	"		"					3	"			"	3/32	51.0	"	"	"	"	"	"	"	"	"	"	"	"
		4	"			1/7	43.7		"	"	"	"		"					4	"			"	5/32	42.1	"	"	"	"	"	"	"	"	"	"	"	"
		5	"			1/32	64.8		"	"	"	"		"					5	"			"	3/32	51.0	"	"	"	"	"	"	"	"	"	"	"	"
5		1	Oct 11			1/8	40.9		"	"	31.0	31.0		31.0					1	July 8			20.3	1/4	33.3	327.840	327.840	22.00	22.00			22.00					
		2	"			1/7	43.7		290.051	"	31.9	"		31.9					2	"			"	3/16	38.7	"	"	"	"	"	"	"	"	"	"	"	"
		3	"			1/7	43.7		289.951	"	32.0	"		32.0					3	July 9			22.8	1/4	33.3	325.390	"	24.45	"	"	24.45	"	24.45	"	24.45		
		4	"			1/7	43.7		287.451	"	34.5	"		34.5					4	"			22.8	1/4	33.3	325.370	"	24.47	"	"	24.47	"	24.47	"	24.47		
		5	"			1/5	37.5		290.951	"	31.0	31.0		31.0					5	"			20.3	1/4	33.3	327.840	"	22.00	"	"	22.00	"	22.00	"	22.00		
6		1	Oct 13			1/8	40.9		285.951	"	36.0	"		36.0																							
		2	"			1/8	40.9		285.251	"	36.5	"		36.5																							
		3	"			1/8	40.9		285.051	"	36.9	"		36.9																							
		4	"			1/8	40.9		285.451	"	36.5	"		36.5																							
		5	"			1/8	40.9		285.451	"	36.5	"		36.5																							
7		1	Oct 14			1/8	37.5		288.751	"	27.2	25.0		27.2																							
		2	"			1/8	37.5		289.951	"	26.0	"		26.0																							
		3	"			1/8	37.5		289.851	"	26.1	"		26.1																							
		4	"			1/8	37.5		290.351	"	25.6	"		25.6																							
		5	"			1/4	33.3		287.751	"	28.2	"		28.2																							
TOTAL														TOTAL																							
GRAND TOTAL														GRAND TOTAL																							
1041.7														1044.5																							
1044.5														1044.5																							

12 x 5' 60 Piles = 2.500 C.Y.
 OR 12 x 5' 60 Piles = 2.500 C.Y.
 2.500 x 60 = 150.00
 150.00 x 1.046 = 156.90
 156.90 x 1.046 = 164.11

40 x 60 = 2400 L.F.
 167.892
 72.558

18

TOTAL			629.92
GRAND TOTAL			1674.42

NOTES CONCERNING ANY UNUSUAL FOUNDATION CONDITION			
BENT NO.	FOOTING	PILE NO.	REMARKS

